

STATE ENGINEER
Salem, Oregon

MARI.....
13274

Well Record

STATE WELL NO. 8/LW-27A(2)
COUNTY Marion
APPLICATION NO. GR- 2255

OWNER: Len R. Edwards


MAILING
ADDRESS: Rt. 3 Box 845

LOCATION OF WELL: Owner's No. 2

CITY AND
STATE: Salem, Oregon

NE 1/4 NE 1/4 Sec. 27 T. 8 S. R. 4 W., W.M.

Bearing and distance from section or subdivision
corner 830' W. & 1003' S. from NE cor. sec. 27

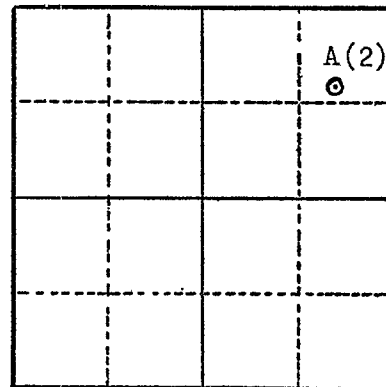

Section 27

Altitude at well

TYPE OF WELL: Drilled Date Constructed 1949

Depth drilled 33' Depth cased

CASING RECORD:
10 inch

FINISH:

Casing perforated

AQUIFERS:

Sand & gravel from 15 to 33 feet

WATER LEVEL:

10 feet below land surface

PUMPING EQUIPMENT: Type F. M. H.P. 15
Capacity 300 G.P.M.

WELL TESTS:

Drawdown 10 ft. after 350 hours G.P.M.

Drawdown ft. after hours G.P.M.

USE OF WATER Irrigation (25 acres) Temp. °F. 19

SOURCE OF INFORMATION GR- 2152

DRILLER or DIGGER Art Clinton

ADDITIONAL DATA:

Log X Water Level Measurements Chemical Analysis Aquifer Test

REMARKS:

Clay & sandy loam 0 to 15
Sand & gravel 15 to 33