

STATE ENGINEER
Salem, Oregon

MARI...
13272
Well Record

STATE WELL NO. 8/4W-27B
COUNTY Marion
APPLICATION NO. GR-3777

OWNER: Paul F. Burris

MAILING
ADDRESS: 659 Cottage NE

LOCATION OF WELL: Owner's No. 2


CITY AND
STATE: Salem, Oregon

NW 1/4 NE 1/4 Sec. 27 T. 8 N. S. R. 4 E. W., W.M.

Bearing and distance from section or subdivision

corner 450 feet South and 570 feet East from

N 1/4 Corner, Section 27

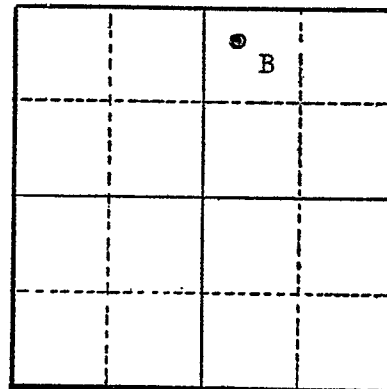

Section 27

Altitude at well 100 feet

TYPE OF WELL: Drilled Date Constructed 1930

Depth drilled 30 feet Depth cased 30 feet

CASING RECORD:

12-inch steel casing set from 2 to 30 feet

FINISH:

perforated

AQUIFERS:

sandy silt loam and gravel

WATER LEVEL:

20 feet

PUMPING EQUIPMENT: Type Fairbanks Morse

Capacity 450 G.P.M.

H.P.

WELL TESTS:

Drawdown 1 ft. after 450 hours G.P.M.

Drawdown ft. after hours G.P.M.

USE OF WATER Irrigation

Temp. °F. 19

SOURCE OF INFORMATION GR-4154

DRILLER or DIGGER

ADDITIONAL DATA:

Log ^x Water Level Measurements Chemical Analysis Aquifer Test

REMARKS:

sandy silt loam 18 28

gravel 10 28