

STATE ENGINEER
Salem, Oregon

MARI.....
13273

Well Record

STATE WELL NO. 8/4W-27C
COUNTY Marion
APPLICATION NO. GR-3776

OWNER: Paul F. Burris


MAILING ADDRESS: 659 Cottage NE

LOCATION OF WELL: Owner's No. 1

CITY AND STATE: Salem, Oregon

NE 1/4 NW 1/4 Sec. 27 T. 8 S. R. 4 W., W.M.

Bearing and distance from section or subdivision
corner 350 feet West and 770 feet South from the N1/4
Corner, Section 27

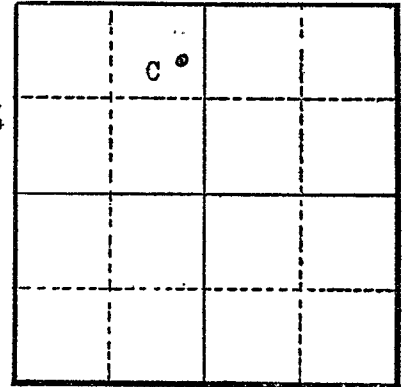

Section 27

Altitude at well 100 feet

TYPE OF WELL: Drilled Date Constructed 1930

Depth drilled 30 feet Depth cased 30 feet

CASING RECORD:

12-inch steel casing set from +2 to 30 feet

FINISH:

AQUIFERS:

sandy silt loam and gravel

WATER LEVEL:

20 feet

PUMPING EQUIPMENT: Type Fairbanks, H.P.
Capacity 450 G.P.M.

WELL TESTS:

Drawdown 1 ft. after 450 hours G.P.M.

Drawdown ft. after hours G.P.M.

USE OF WATER Irrigation Temp. °F. 19

SOURCE OF INFORMATION GR-4153

DRILLER or DIGGER

ADDITIONAL DATA:

Log ☒ Water Level Measurements Chemical Analysis Aquifer Test

REMARKS:

sandy silt loam 18 28
gravel 10 28