

STATE ENGINEER
Salem, Oregon

MAR 1939
13274

Well Record

STATE WELL NO. 8/4W-27C
COUNTY MARION
APPLICATION NO. GR-2482

OWNER: Eugene D. MacCarthy

MAILING ADDRESS: Rt. 3, Box 833


LOCATION OF WELL: Owner's No.

CITY AND STATE: Salem, Oregon

NE 1/4 NW 1/4 Sec. 27 T. 8 S., R. 4 W., W.M.

Bearing and distance from section or subdivision

corner 905' S. & 1310' W.

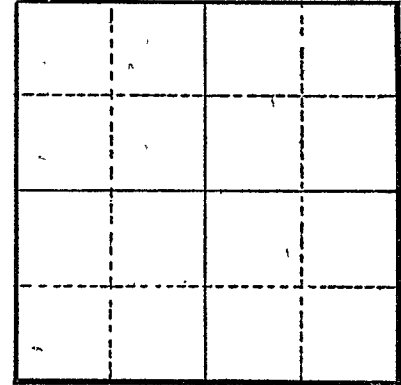

Section

Altitude at well

TYPE OF WELL: Drilled Date Constructed 1939

Depth drilled 35 Depth cased 35

CASING RECORD:

12-inch

FINISH:

Torch perforated from 20' to 35'

AQUIFERS:

Soil, gravel and sand

WATER LEVEL:

12-feet

PUMPING EQUIPMENT: Type Fairbanks Split Case H.P. 75
Capacity 1500 G.P.M.

WELL TESTS:

Drawdown 5 ft. after hours Pumping 1500+ G.P.M.

Drawdown ft. after hours G.P.M.

USE OF WATER Irrigation Temp. °F. 19

SOURCE OF INFORMATION GR-2350

DRILLER or DIGGER Sneed & Sons, Salem, Oregon

ADDITIONAL DATA:

Log X Water Level Measurements Chemical Analysis Aquifer Test

REMARKS:

Soil 12 12
River gravel and sand Balance of Depth