

STATE ENGINEER
Salem, Oregon

MARI.....
13277

Well Record

STATE WELL NO. 8/W-27H(2)
COUNTY Marion
APPLICATION NO. GR-2257

OWNER: Len R. Edwards


MAILING ADDRESS: Rt. 3 Box 815

LOCATION OF WELL: Owner's No. 4

CITY AND STATE: Salem, Oregon

SE 1/4 NE 1/4 Sec. 27 T. 8 S, R. 4 W, W.M.

Bearing and distance from section or subdivision corner 830' W. & 2602' S. from NE cor. sec. 27

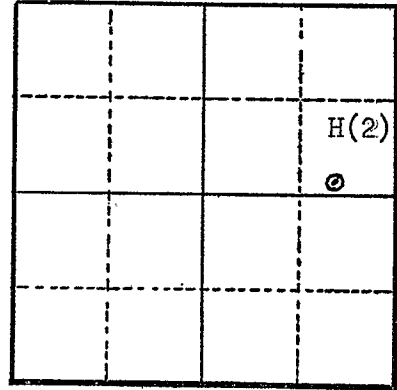

Section 27

Altitude at well

TYPE OF WELL: Drilled Date Constructed 1950

Depth drilled 33' Depth cased

CASING RECORD:
10 inch

FINISH:
Casing perforated

AQUIFERS:
Sand & gravel from 14 to 33 feet

WATER LEVEL:

PUMPING EQUIPMENT: Type F. M. H.P. 15
Capacity 300 G.P.M.

WELL TESTS:
Drawdown 10 ft. after 350 hours G.P.M.
Drawdown ft. after hours G.P.M.

USE OF WATER Irrigation (20 acres) Temp. °F. 19

SOURCE OF INFORMATION GR-2154
DRILLER or DIGGER Art Clinton

ADDITIONAL DATA:
Log Water Level Measurements Chemical Analysis Aquifer Test

REMARKS:
Clay & sandy loam 0 to 14
Sand & gravel 14 to 33