

STATE ENGINEER
Salem, Oregon

MARI.....
13278

Well Record

STATE WELL NO. 8/4W-27J
COUNTY MARION
APPLICATION NO. GR-2485

OWNER: Eugene D. MacCarthy

MAILING ADDRESS: Rt. 3, Box 833,


LOCATION OF WELL: Owner's No. #4

CITY AND STATE: Salem, Oregon

NE 1/4 SE 1/4 Sec. 27 T. 8 S., R. 4 W., W.M.

Bearing and distance from section or subdivision

corner 505' S. & 235' W.

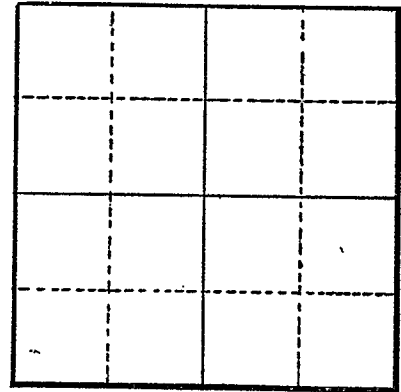

Section

Altitude at well

TYPE OF WELL: Drilled Date Constructed 1950

Depth drilled 30 Depth cased 30

CASING RECORD:

10-inch

FINISH:

Torch perforated from 18' to 30'

AQUIFERS:

Soil, gravel & Sand

WATER LEVEL:

8-feet

PUMPING EQUIPMENT: Type Fairbanks

H.P. 75

Capacity 1500 G.P.M.

WELL TESTS:

Drawdown 4 ft. after hours Pumping 1000+ G.P.M.

Drawdown ft. after hours G.P.M.

USE OF WATER Irrigation

Temp. °F. 19

SOURCE OF INFORMATION GR-2353

DRILLER or DIGGER A. Clinton, Independence, Oregon

ADDITIONAL DATA:

Log Water Level Measurements Chemical Analysis Aquifer Test

REMARKS:

Soil Top 8'
River gravel & sand Balance of depth