

STATE ENGINEER
Salem, Oregon

MARI...
13281

Well Record

STATE WELL NO. 8/LW-27N
COUNTY Marion
APPLICATION NO. GR-1649

GR-1764

OWNER: R. M. Walker


MAILING ADDRESS:

LOCATION OF WELL: Owner's No. #1

CITY AND STATE: Independence, Oregon

SW 1/4 SW 1/4 Sec. 27 T. 8 S., R. 4 W., W.M.

Bearing and distance from section or subdivision corner N.89°45'E. 1033' from NW cor. Sec. 34

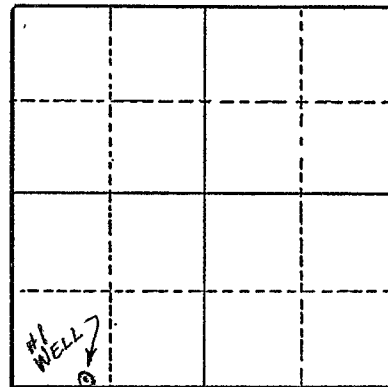

Section 27

Altitude at well 155'

TYPE OF WELL: Drilled Date Constructed 1938

Depth drilled 40' Depth cased 40'

CASING RECORD:

8"

FINISH:

AQUIFERS:

WATER LEVEL:

15'

PUMPING EQUIPMENT: Type F. M. H.P. 30
Capacity 550 G.P.M.

WELL TESTS:

Drawdown ft. after hours G.P.M.
Drawdown ft. after hours G.P.M.

USE OF WATER Irrigation Temp. °F. 19

SOURCE OF INFORMATION GR Record

DRILLER or DIGGER

ADDITIONAL DATA:

Log N.A. Water Level Measurements Chemical Analysis Aquifer Test

REMARKS:

Irrigation of 27.7 acres.