

STATE ENGINEER  
Salem, Oregon

MARION  
13282

# Well Record

STATE WELL NO. ...8/4W-27P...  
COUNTY ...Marion...  
APPLICATION NO. ...GR-1652...

GR- 1773

OWNER: R.M. Walker


MAILING  
ADDRESS:

LOCATION OF WELL: Owner's No. Cooper

CITY AND  
STATE: Independence, Oregon

SE 1/4 SW 1/4 Sec. 27 T. 8 S., R. 4 W., W.M.

Bearing and distance from section or subdivision  
corner N. 71° 14' E. 785' from S<sup>1</sup>/<sub>4</sub> cor. Sec. 27

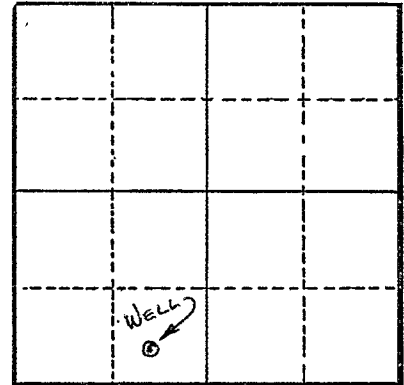

Section 27

Altitude at well 155'

TYPE OF WELL: Drilled Date Constructed 1947

Depth drilled ? Depth cased ?

### CASING RECORD:

12"

### FINISH:

### AQUIFERS:

### WATER LEVEL:

15'

PUMPING EQUIPMENT: Type DeLaval 6/5 Cent. H.P. 60

Capacity 780 G.P.M.

### WELL TESTS:

Drawdown ft. after hours G.P.M.

Drawdown ft. after hours G.P.M.

USE OF WATER Irrigation Temp. °F. 19

SOURCE OF INFORMATION GR Record

DRILLER or DIGGER

### ADDITIONAL DATA:

Log N.A. Water Level Measurements Chemical Analysis Aquifer Test

### REMARKS:

Irrigation of 53.29 acres.