

STATE ENGINEER
Salem, Oregon

MARI.....
13283

Well Record

STATE WELL NO. 8/4W-270
COUNTY MARION
~~APPLICATION NO. GR-2483~~

OWNER: Eugene D. MacCarthy


MAILING ADDRESS: Rt. 3, Box 833

LOCATION OF WELL: Owner's No.

CITY AND STATE: Salem, Oregon

SW 1/4 SE 1/4 Sec. 27 T. 8 N. S., R. 4 W., W.M.

Bearing and distance from section or subdivision corner 2633' S. and 1360' W.

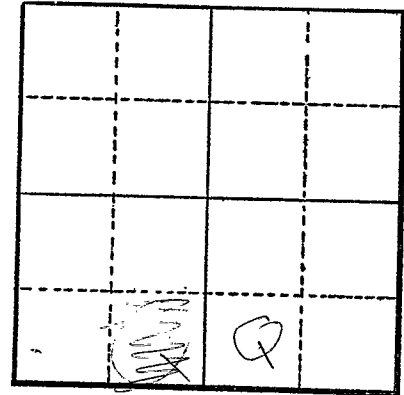

Section

Altitude at well

TYPE OF WELL: Drilled Date Constructed 1948

Depth drilled 32 Depth cased 32

CASING RECORD:

12-inch

FINISH:

Torch perforated from 17 to 32

AQUIFERS:

Soil, gravel and sand

WATER LEVEL:

16-feet

PUMPING EQUIPMENT: Type

Capacity G.P.M. H.P.

WELL TESTS:

Drawdown 6 ft. after hours Pumping 1500 G.P.M.

Drawdown ft. after hours G.P.M.

USE OF WATER Irrigation Temp. °F., 19

SOURCE OF INFORMATION GR-2351

DRILLER or DIGGER A. Sloper, Independence, Oregon

ADDITIONAL DATA:

Log Water Level Measurements Chemical Analysis Aquifer Test

REMARKS:

Soil 12 12
River Gravel & Sand Balance of Depth