

STATE ENGINEER  
Salem, Oregon

MARI. 1329

# Well Record

STATE WELL NO. 4/2W-28C  
COUNTY Marion  
APPLICATION NO. GR-3467

OWNER: Richard McKay


MAILING ADDRESS: Route 1, Box 389

LOCATION OF WELL: Owner's No. Well #2

CITY AND STATE: Woodburn, Oregon

NE 1/4 NW 1/4 Sec. 28 T. 4 N. S., R. 2 E. W., W.M.

Bearing and distance from section or subdivision corner 1150' S. and 1300' from N 1/4 Corn. Sec. 28

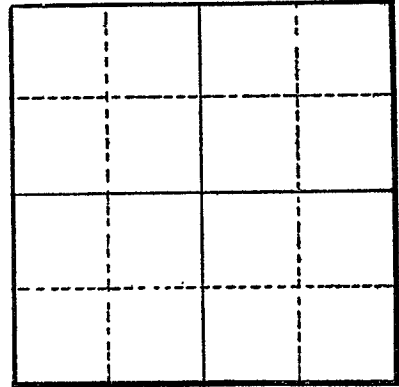

Section .....

Altitude at well .....

TYPE OF WELL: drilled Date Constructed 1952

Depth drilled 117' Depth cased 117'

### CASING RECORD:

10"

### FINISH:

### AQUIFERS:

### WATER LEVEL:

17'

PUMPING EQUIPMENT: Type Fairbanks Morse Turbine H.P. 20  
Capacity 500 G.P.M.

### WELL TESTS:

Drawdown 85 ft. after ..... hours ..... pumping 500 G.P.M.  
Drawdown 55 ft. after ..... hours ..... pumping 350 G.P.M.

USE OF WATER Irrigation Temp. .... °F. ...., 19

SOURCE OF INFORMATION GR-3207

DRILLER or DIGGER Perkins Salem, Oregon

### ADDITIONAL DATA:

Log ..... Water Level Measurements ..... Chemical Analysis ..... Aquifer Test .....

### REMARKS: