

STATE ENGINEER
Salem, Oregon

MAR 13 2 1940

Well Record

GR- 1769

STATE WELL NO. 8/4W-28A
COUNTY Marion
APPLICATION NO. GR-1655

OWNER: 4-D Farms


MAILING ADDRESS: Box 82

LOCATION OF WELL: Owner's No. #3

CITY AND STATE: Independence, Oregon

NE 1/4 NE 1/4 Sec. 28 T. 8 S., R. 4 W., W.M.

Bearing and distance from section or subdivision corner N.3°16'W. 857.5' & N.30°56'W. 1813.7' from E 1/4 cor. of Sec. 28

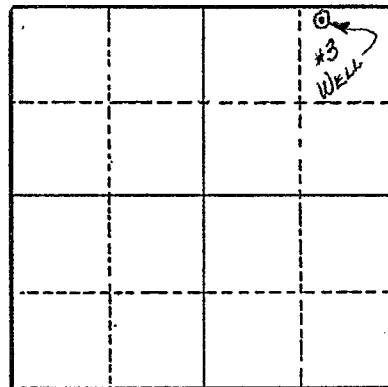

Section 28

Altitude at well 155'

TYPE OF WELL: Drilled Date Constructed 1942

Depth drilled 36' Depth cased 36'

CASING RECORD:

12"

FINISH:

AQUIFERS:

WATER LEVEL:

15'

PUMPING EQUIPMENT: Type F. M. 5/4 in. H.P. 50
Capacity 800 G.P.M.

WELL TESTS:

Drawdown ft. after hours G.P.M.
Drawdown ft. after hours G.P.M.

USE OF WATER Irrigation Temp. °F. 19

SOURCE OF INFORMATION GR Record

DRILLER or DIGGER

ADDITIONAL DATA:

Log N.A. Water Level Measurements Chemical Analysis Aquifer Test

REMARKS:

Irrigation of 53 acres.