

STATE ENGINEER
Salem, Oregon

MARION... 13293
Well Record

GR- 1767

STATE WELL NO. B/4W-28H
COUNTY Marion
APPLICATION NO. GR- 1653

OWNER: Oregon Hop Co.-Assigned to
4-D Farms


MAILING ADDRESS: Box 82

LOCATION OF WELL: Owner's No. #1

CITY AND STATE: Independence, Oregon

SE 1/4 NE 1/4 Sec. 28 T. 8 S., R. 4 W., W.M.

Bearing and distance from section or subdivision
corner N.3°16'W. 857.5' from E¹/₄ cor. Sec. 28

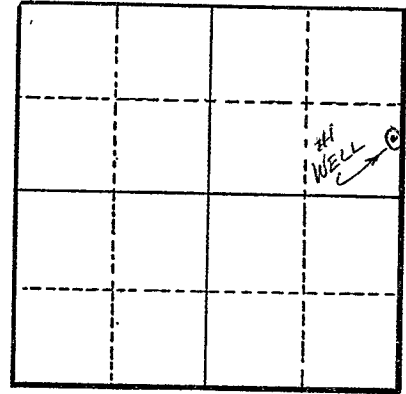

Section 28

Altitude at well 155'

TYPE OF WELL: Drilled Date Constructed 1947

Depth drilled 34' Depth cased 34'

CASING RECORD:
12"

FINISH:

AQUIFERS:

WATER LEVEL:
12'

PUMPING EQUIPMENT: Type Pacific H.P. 30
Capacity 600 G.P.M.

WELL TESTS:
Drawdown ft. after hours G.P.M.
Drawdown ft. after hours G.P.M.

USE OF WATER Irrigation Temp. °F. 19

SOURCE OF INFORMATION GR Record

DRILLER or DIGGER

ADDITIONAL DATA:
Log N.A. Water Level Measurements Chemical Analysis Aquifer Test

REMARKS:

Irrigation of 61.5 acres.