

STATE ENGINEER
Salem, Oregon

13297
MARI....

Well Record

GR- 1766

STATE WELL NO. 8/4W-33A
COUNTY Marion
APPLICATION NO. GR- 1651


OWNER: R. M. Walker

MAILING ADDRESS:

LOCATION OF WELL: Owner's No. #3

CITY AND STATE: Independence, Oregon

NE 1/4 NE 1/4 Sec. 33 T. 8 S, R. 4 W, W.M.

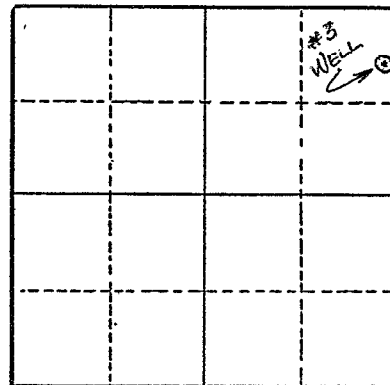

Bearing and distance from section or subdivision corner S. 8°26' W. 606.5' from NE cor. Sec. 33

Altitude at well 155'

TYPE OF WELL: Drilled Date Constructed 1944

Depth drilled 34' Depth cased 34'

Section 33

CASING RECORD:

12"

FINISH:

AQUIFERS:

WATER LEVEL:

14'

PUMPING EQUIPMENT: Type F. M. H.P. 30
Capacity 550 G.P.M.

WELL TESTS:

Drawdown ft. after hours G.P.M.
Drawdown ft. after hours G.P.M.

USE OF WATER Irrigation Temp. °F. 19

SOURCE OF INFORMATION GR Record

DRILLER or DIGGER

ADDITIONAL DATA:

Log N.A. Water Level Measurements Chemical Analysis Aquifer Test

REMARKS:

Irrigation of 27.6 acres.