

STATE ENGINEER  
Salem, Oregon

MARI..... 13298

# Well Record

GR- 1765

STATE WELL NO. 8/4W-34D  
COUNTY Marion  
APPLICATION NO. GR- 1650

OWNER: R. M. Walker


MAILING  
ADDRESS:

LOCATION OF WELL: Owner's No. #2

CITY AND  
STATE: Independence, Oregon

NW 1/4 NW 1/4 Sec. 34 T. 8 S, R. 4 W., W.M.

Bearing and distance from section or subdivision  
corner S. 63°44'E. 1358' from NW cor. Sec. 34

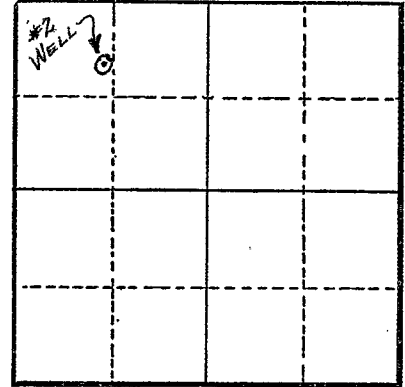

Section 34

Altitude at well 155'

TYPE OF WELL: Drilled Date Constructed 1953

Depth drilled 40' Depth cased 40'

### CASING RECORD:

12"

### FINISH:

### AQUIFERS:

### WATER LEVEL:

15'

PUMPING EQUIPMENT: Type E. M. H.P. 30

Capacity 550 G.P.M.

### WELL TESTS:

Drawdown ft. after hours G.P.M.

Drawdown ft. after hours G.P.M.

USE OF WATER Irrigation Temp. °F. 19

SOURCE OF INFORMATION GR Record

DRILLER or DIGGER

### ADDITIONAL DATA:

Log N.A. Water Level Measurements Chemical Analysis Aquifer Test

### REMARKS:

Irrigation of 46.2 acres.