

STATE ENGINEER
Salem, Oregon

MARI. 133

Well Record

STATE WELL NO. 3/1W-32R(1)
COUNTY Marion
APPLICATION NO.

OWNER: Smith & Hubbard Dairy


MAILING ADDRESS:

LOCATION OF WELL: Owner's No.

CITY AND STATE:

1/4 Sec. T. N. S., R. E. W., W.M.

Bearing and distance from section or subdivision corner

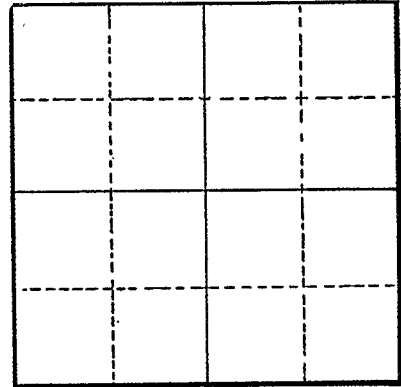

Section

Altitude at well 190

TYPE OF WELL: Drilled Date Constructed 1946

Depth drilled 200 Depth cased

CASING RECORD:

6 inch

FINISH:

AQUIFERS:

WATER LEVEL:

37.60 feet below land surface on February 1, 1960

PUMPING EQUIPMENT: Type Turbine H.P. 10
Capacity G.P.M.

WELL TESTS:

Drawdown ft. after hours G.P.M.
Drawdown ft. after hours G.P.M.

USE OF WATER Irrigation --31 acres Temp. °F., 19

SOURCE OF INFORMATION USGS

DRILLER or DIGGER

ADDITIONAL DATA:

Log Water Level Measurements Chemical Analysis Aquifer Test

REMARKS: