

STATE ENGINEER
Salem, Oregon

Markham 13308
Well Record

STATE WELL NO. 8/LW-35 F
COUNTY Marion
APPLICATION NO. GR-3316

OWNER: La Vern H. Dalckenberg


MAILING ADDRESS: Route 3, Box 820

LOCATION OF WELL: Owner's No.

CITY AND STATE: Salem, Oregon

SE 1/4 NW 1/4 Sec. 35 T. 8 N S., R. 4 W., W.M.

Bearing and distance from section or subdivision corner 1320' E and 2120' S.

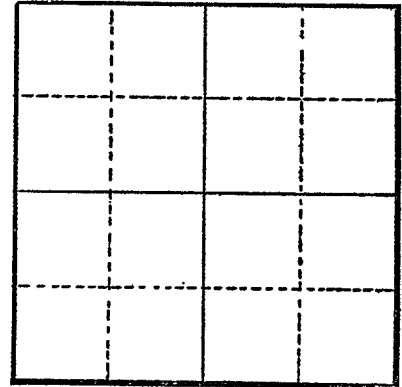

Section

Altitude at well

TYPE OF WELL: drilled Date Constructed 1951

Depth drilled 38' Depth cased 38'

CASING RECORD:

12"

FINISH:

8 - 12 slots 1/2" x 6" long from 23' to 38'

AQUIFERS:

Soil, gravel & blue clay

WATER LEVEL:

15'

PUMPING EQUIPMENT: Type Fairbanks Morse
Capacity 600-800 G.P.M.

H.P. 50

WELL TESTS:

Drawdown 3-6 ft. after hours pumping 600-800 G.P.M.

Drawdown ft. after hours G.P.M.

USE OF WATER Irrigation Temp. °F., 19

SOURCE OF INFORMATION GR- 3077

DRILLER or DIGGER

ADDITIONAL DATA:

Log Water Level Measurements Chemical Analysis Aquifer Test

REMARKS:

Soil 15'
Gravel 22
Blue Clay 1 38