

STATE ENGINEER  
Salem, Oregon

MARI..... 13309  
Well Record

STATE WELL NO. 8/LW-35K(1)  
COUNTY Marion  
APPLICATION NO. GR-2258

OWNER: Len R. Edwards


MAILING ADDRESS: Rt. 3 Box 845

LOCATION OF WELL: Owner's No. \_\_\_\_\_

CITY AND STATE: Salem, Oregon

NW  $\frac{1}{4}$  SE  $\frac{1}{4}$  Sec. 35 T. 8 <sup>XX</sup> S., R. 4 <sup>XX</sup> W., W.M.

Bearing and distance from section or subdivision  
corner 2640' S. & 1663' W. from NE cor. sec. 35

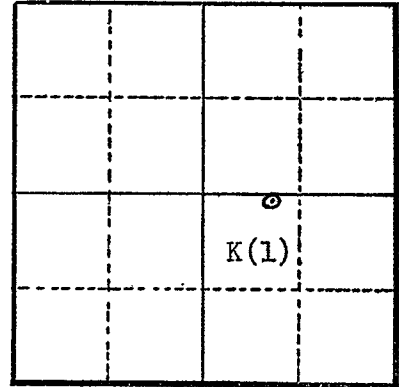

Section 35

Altitude at well \_\_\_\_\_

TYPE OF WELL: Drilled Date Constructed 1951

Depth drilled 35 Depth cased \_\_\_\_\_

CASING RECORD:  
12 inch

FINISH:

Casing perforated

AQUIFERS:

Sand & gravel from 12 to 35 feet

WATER LEVEL:

15 feet below land surface

PUMPING EQUIPMENT: Type F. M. H.P. 40  
Capacity 750 G.P.M.

WELL TESTS:

Drawdown \_\_\_\_\_ ft. after \_\_\_\_\_ hours \_\_\_\_\_ G.P.M.  
Drawdown \_\_\_\_\_ ft. after \_\_\_\_\_ hours \_\_\_\_\_ G.P.M.

USE OF WATER Irrigation ( 70 acres) Temp. \_\_\_\_\_ °F. \_\_\_\_\_, 19\_\_\_\_\_

SOURCE OF INFORMATION GR-2155

DRILLER or DIGGER Art Clinton

ADDITIONAL DATA:

Log X Water Level Measurements \_\_\_\_\_ Chemical Analysis \_\_\_\_\_ Aquifer Test \_\_\_\_\_

REMARKS:

Sandy loam 0 to 12  
Sand & gravel 12 to 35