

STATE ENGINEER
Salem, Oregon

OBSERVATION WELL
Well Record

STATE WELL NO. 4/2W-28N(1)
COUNTY Marion
APPLICATION NO. GR-763
G-4925

MAR. 1331

OWNER: Joseph B. Wolf


MAILING ADDRESS: Route 1, Box 303

LOCATION OF WELL: Owner's No. 1

CITY AND STATE: St. Paul, Oregon

SW 1/4 SW 1/4 Sec. 28 T. 4 S. R. 2 W., W.M.

Bearing and distance from section or subdivision corner 1100' N. & 1150' E. from SW cor. Sec. 28

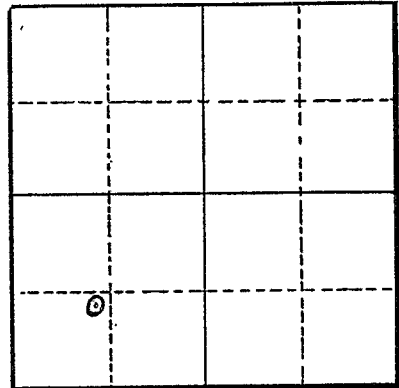

Section 28

Altitude at well 169'

TYPE OF WELL: Drilled Date Constructed 10/29/52

Depth drilled 216' Depth cased 204'

CASING RECORD:

18 inch steel casing from 0 to 204 feet

FINISH:

AQUIFERS:

WATER LEVEL:

58 feet

PUMPING EQUIPMENT: Type Peerless pump H.P. 20
Capacity 350 G.P.M.

WELL TESTS:

Drawdown 32 ft. after _____ hours pumping 500 G.P.M.
Drawdown _____ ft. after _____ hours _____ G.P.M.

USE OF WATER Irrigation 163 acres Temp. _____ °F., 19 _____

SOURCE OF INFORMATION GR-763

DRILLER or DIGGER J. T. Miller Aurora, Oregon

ADDITIONAL DATA:

Log Yes Water Level Measurements _____ Chemical Analysis _____ Aquifer Test _____

REMARKS:

