

STATE ENGINEER  
Salem, Oregon

MARI. 1337

# Well Record

STATE WELL NO. 4/2W-29B(1)  
COUNTY Marion  
APPLICATION NO. GR-1377

GR- 1334

OWNER: Theodore M. Van Dyke


MAILING  
ADDRESS:

LOCATION OF WELL: Owner's No. #1

CITY AND  
STATE: ST Paul, Oregon

NW 1/4 NE 1/4 Sec. 29 T. 4 S., R. 2 W., W.M.

Bearing and distance from section or subdivision  
corner 2620' S. 83°W. from NE cor. Sec. 29

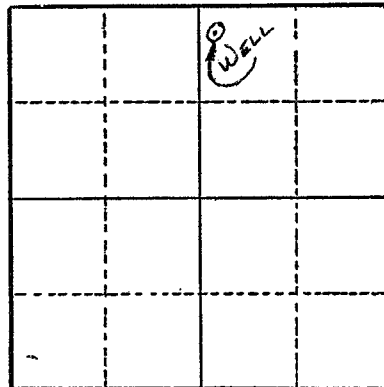

Section 29

Altitude at well 200 ft.

TYPE OF WELL: Drilled Date Constructed 1955

Depth drilled 152 ft. Depth cased 152 ft.

### CASING RECORD:

12 in. steel casing from 42 to 110 ft.  
8 in. steel casing from 0 to 152 ft.

### FINISH:

8 in. casing perforated from 95 to 99 ft.  
8 in. casing perforated from 140 to 150 ft.

### AQUIFERS:

### WATER LEVEL:

21 ft. (2- -55)

PUMPING EQUIPMENT: Type Bingham turbine H.P. 15  
Capacity 220 G.P.M.

### WELL TESTS:

Drawdown 30 ft. after hours 280 G.P.M.  
Drawdown 57 ft. after hours 600 G.P.M.

USE OF WATER Irrigation Temp. °F., 19

SOURCE OF INFORMATION G. R. Record

DRILLER or DIGGER J. T. Miller

### ADDITIONAL DATA:

Log  Water Level Measurements Chemical Analysis Aquifer Test

### REMARKS:

Irrigation of 29.7 acres.

