

STATE ENGINEER
Salem, Oregon

MARI. 1341

Well Record

STATE WELL NO. 4/2W-29M
COUNTY Marion
APPLICATION NO. GR-1477


GR- 1426

OWNER: Edward F. Davidson
MAILING ADDRESS: _____
CITY AND STATE: St. Paul, Oregon

LOCATION OF WELL: Owner's No. _____

NW ¼ SW ¼ Sec. 29 T. 4 S., R. 2 W., W.M.

Bearing and distance from section or subdivision corner 1000' E. & 2400' N. from SW cor. Sec. 29

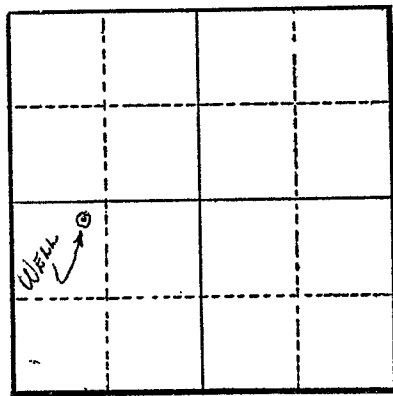

Section 29

Altitude at well 16.2

TYPE OF WELL: Drilled Date Constructed 1953

Depth drilled 216' Depth cased 216'

CASING RECORD:

10"

FINISH:

Perforated at 106'

AQUIFERS:

WATER LEVEL:

20'

PUMPING EQUIPMENT: Type Peerless turbine H.P. 20

Capacity 400 G.P.M.

WELL TESTS:

Drawdown 65 ft. after 400 hours G.P.M.

Drawdown _____ ft. after _____ hours G.P.M.

USE OF WATER Irrigation Temp. °F. 19

SOURCE OF INFORMATION GR Record

DRILLER or DIGGER J. T. Miller

ADDITIONAL DATA:

Log N. A. Water Level Measurements Chemical Analysis Aquifer Test

REMARKS:

Irrigation of 109 acres