

NOTICE TO WATER WELL CONTRACTOR:

The original and first copy of this report are to be filed with the

STATE ENGINEER, SALEM, OREGON 97310 within 30 days from the date of well completion.

RECEIVED MAR 14 1966 STATE OF OREGON (Please type or print) STATE ENGINEER SALEM, OREGON

G-3768

State Well No. 4/2w-29N

State Permit No.

(1) OWNER:

Name Ray Davidson
Address Star Rt., Box 21
St. Paul, Oregon

(2) LOCATION OF WELL:

County Marion Driller's well number
1/4 1/4 Section 29 T. 4S R. 2W W.M.
Bearing and distance from section or subdivision corner

(3) TYPE OF WORK (check):

New Well [X] Deepening [ ] Reconditioning [ ] Abandon [ ]
If abandonment, describe material and procedure in Item 12.

(4) PROPOSED USE (check):

Domestic [ ] Industrial [ ] Municipal [ ]
Irrigation [X] Test Well [ ] Other [ ]

(5) TYPE OF WELL:

Rotary [ ] Driven [ ]
Cable [ ] Jetted [ ]
Dug [ ] Bored [ ]

(6) CASING INSTALLED:

Threaded [ ] Welded [ ]
18" Diam. from 0 ft. to 86 ft. Gage .250
12" Diam. from 0 ft. to 162 ft. Gage .250
16" Diam. from 162 ft. to 163 ft. Gage .375

(7) PERFORATIONS:

Perforated? [X] Yes [ ] No
Type of perforator used torch
Size of perforations 3/8 in. by 8 in.
960 perforations from 62 ft. to 162 ft.
perforations from ft. to ft.
perforations from ft. to ft.
perforations from ft. to ft.

(8) SCREENS:

Well screen installed? [ ] Yes [X] No
Manufacturer's Name
Model No.
Slot size Set from ft. to ft.
Diam. Slot size Set from ft. to ft.

(9) CONSTRUCTION:

Well seal—Material used in seal bentonite & sand
Depth of seal 36 ft. Was a packer used? no
Diameter of well bore to bottom of seal 24 in.
Were any loose strata cemented off? [ ] Yes [X] No Depth
Was a drive shoe used? [ ] Yes [X] No
Was well gravel packed? [X] Yes [ ] No Size of gravel: 3/8 - 3/4
Gravel placed from 0 ft. to 162 ft.
Did any strata contain unusable water? [ ] Yes [X] No
Type of water? depth of strata
Method of sealing strata off

(10) WATER LEVELS:

Static level 18 ft. below land surface Date 3-5-66
Artesian pressure lbs. per square inch Date

(11) WELL TESTS:

Drawdown is amount water level is lowered below static level
Was a pump test made? [X] Yes [ ] No If yes, by whom? driller
Yield: gal./min. with ft. drawdown after hrs.
" " " "
" see attached sheet " "
Baller test gal./min. with ft. drawdown after hrs.
Artesian flow g.p.m. Date
Temperature of water 55 Was a chemical analysis made? [ ] Yes [X] No

(12) WELL LOG:

Diameter of well below casing 0
Depth drilled 236 1/2 ft. Depth of completed well 161 ft.
Formation: Describe by color, character, size of material and structure, and show thickness of aquifers and the kind and nature of the material in each stratum penetrated, with at least one entry for each change of formation.

Table with 3 columns: MATERIAL, FROM, TO. Rows include: top (0-2), brown clay (2-14), sandy brown clay (water) (14-34), soft blue clay (34-54), sticky blue clay (54-88), sand brown (88-95), sand & gravel (95-98), sand (98-102), light brown clay (102-104), dark brown clay (104-127), sand & wood (127-130), silty clay (130-135), hard dark brown clay (135-137), sand & gravel (fine) (137-146), sand (146-152), brown clay (152-159 1/2), well was developed here, we drilled 12" hole below (159 1/2-168), blue clay (168-172), brown clay (172-177), soft brown clay (177-196), extra hard brown clay (196-210), soft light brown clay (210-234), silty brown clay (224-230).

Work started 12-4 1965. Completed 3-5 1966
Date well drilling machine moved off of well 19

(13) PUMP:

hard brown filled hole w/ gravel 230 236 1/2
Manufacturer's Name
Type: H.P.

Water Well Contractor's Certification:

This well was drilled under my jurisdiction and this report is true to the best of my knowledge and belief.

NAME Milo Schneider Equipment Co.
(Person, firm or corporation) (Type or print)
Address Star Rt., Box 97, St. Paul, Ore.
Drilling Machine Operator's License No. 212
[Signed] Milo Schneider (Water Well Contractor)
Contractor's License No. 387 Date 3-5-1966

4/2w-29N  
Marion


PRINTED IN U.S.A. ON CLEARPENT TECHNICAL PAPER NO. 1913

REPRODUCED

Ray Davidson  
Virginia Hall  
2-12-66


STATE ENGINEER  
SALEM, OREGON

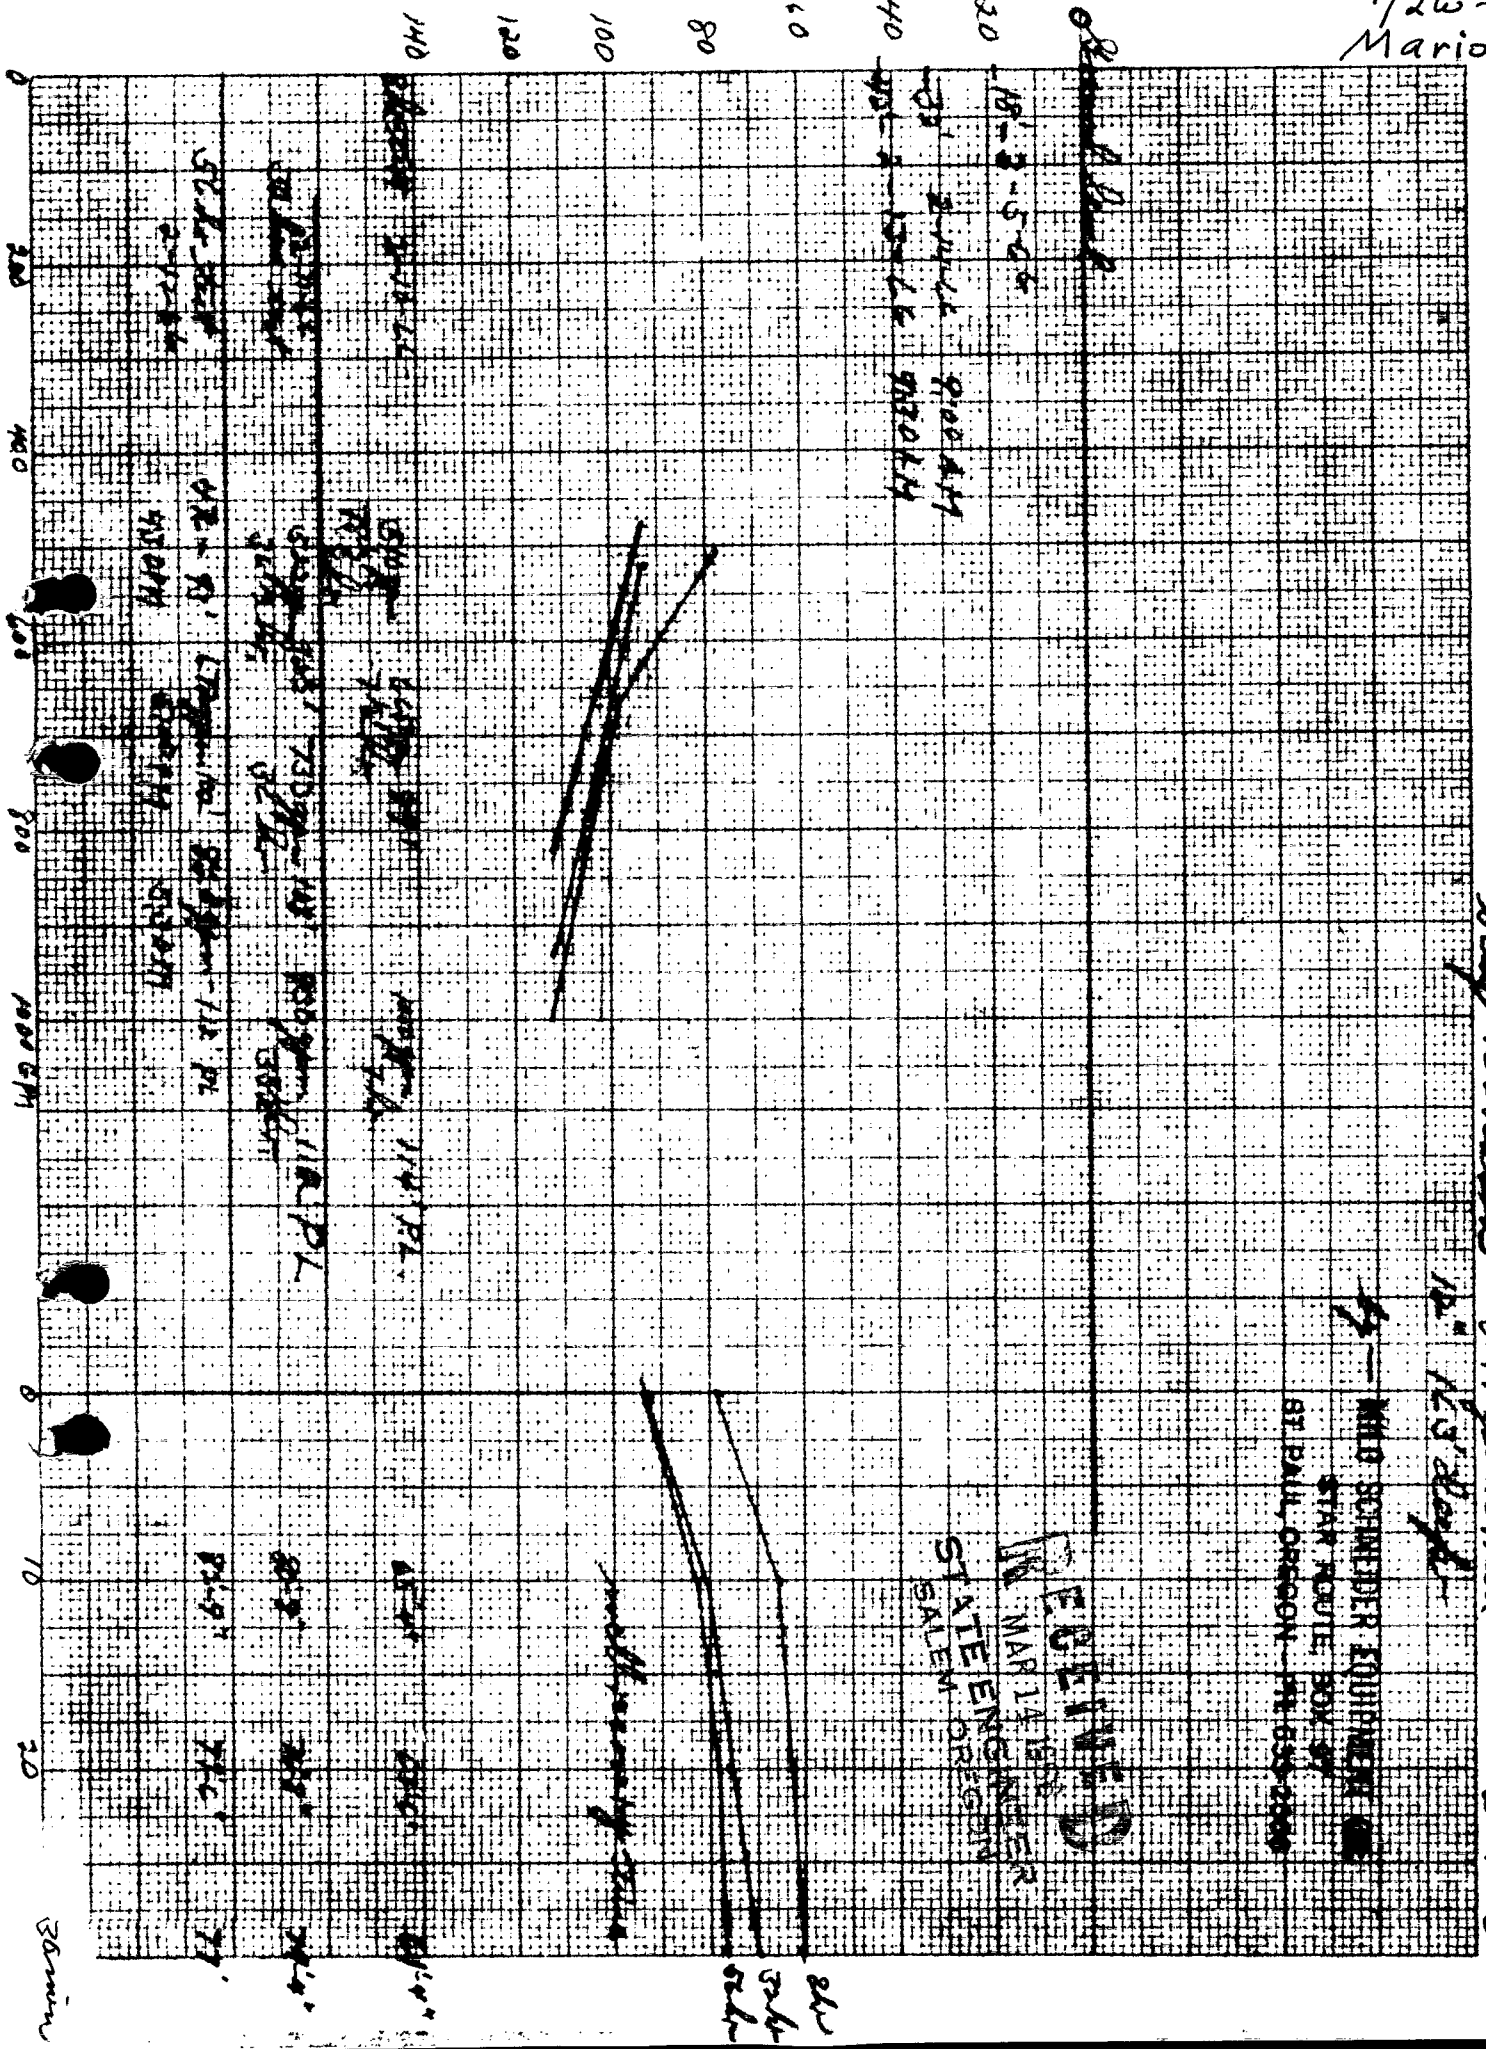

30min