

STATE ENGINEER
Salem, Oregon

MARI...1352

Well Record

GR- 1540

STATE WELL NO. 4/2W-30J(1)
COUNTY Marion
APPLICATION NO. GR- 1592

OWNER: Donald Davidson

MAILING ADDRESS:

Star Rt., Box 22

LOCATION OF WELL: Owner's No.

CITY AND STATE:


St. Paul, Oregon

NE 1/4 SE 1/4 Sec. 30 T. 4 S., R. 2 W., W.M.

Bearing and distance from section or subdivision

corner 280' N. & 400' W. from NE cor. of Cecil

Bertrand DLC. #89

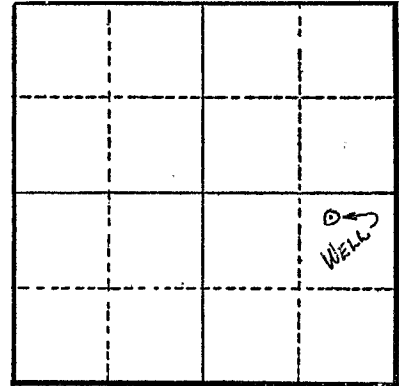

Section 30

Altitude at well 170'

TYPE OF WELL: Drilled Date Constructed 1950

Depth drilled 222' Depth cased 203.75'

~~SCREEN~~ FINISH:

Perforated: 8 - each one ft. long from 125 to 126 ft.

~~SCREEN~~ CASING RECORD:

10"

AQUIFERS:

WATER LEVEL:

19'

PUMPING EQUIPMENT: Type Peerless line shaft turbine H.P. 30

Capacity 340 G.P.M.

WELL TESTS:	126	200
Drawdown	140 ft. after	225 G.P.M.
	160	300
Drawdown	180 ft. after	320 G.P.M.
	204-222	500

USE OF WATER Irrigation Temp. °F. 19

SOURCE OF INFORMATION GR Record

DRILLER or DIGGER J. T. Miller

ADDITIONAL DATA:

Log N.A. Water Level Measurements Chemical Analysis Aquifer Test

REMARKS:

Irrigation of 118.7 acres.