

STATE ENGINEER
Salem, Oregon

Well Record

STATE WELL NO. 9/W-6L(1)
COUNTY Marion
APPLICATION NO. GR-107

MAILED
13554

OWNER: Chester A. & Wilma E. Varnes


MAILING ADDRESS: Rt. 1 Box 310

LOCATION OF WELL: Owner's No. 1

CITY AND STATE: Turner, Oregon

NE 1/4 SW 1/4 Sec. 6 T. 9 S., R. 1 W., W.M.

Bearing and distance from section or subdivision corner 2293.37' S. 79°21' E. from 1/4 cor. on the W. side of sec. 6

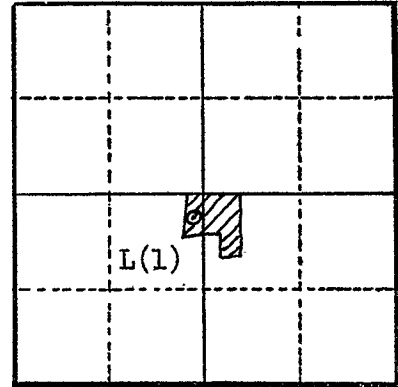

Altitude at well 375 (Interpolated)

TYPE OF WELL: Drilled Date Constructed 1/10/50

Depth drilled 128' Depth cased 128'

Section 6

CASING RECORD:
6 inch from 0 to 128 feet

FINISH:

AQUIFERS:

WATER LEVEL:
50 feet below land surface (4/1/50)

PUMPING EQUIPMENT: Type Monkey Ward Jet 6" H.P. 3/4
Capacity 45 G.P.M.

WELL TESTS:
Drawdown 0 ?? ft. after 45 hours G.P.M.
Drawdown ft. after hours G.P.M.

USE OF WATER Irrigation (40 acres) Temp. °F., 19

SOURCE OF INFORMATION GR- 271
DRILLER or DIGGER Duffield Bros., Salem

ADDITIONAL DATA:
Log NA Water Level Measurements Chemical Analysis Aquifer Test

REMARKS: