

STATE ENGINEER
Salem, Oregon

M.A.R. 13658

Well Record

STATE WELL NO. 9/LW-10D
COUNTY Marion
APPLICATION NO. GR-3199

OWNER: Stayton Canning Company Coop.


MAILING ADDRESS: _____

LOCATION OF WELL: Owner's No. _____

CITY AND STATE: Stayton, Oregon

NW 1/4 NW 1/4 Sec. 10 T. 9 S., R. 1 E., W.M.

Bearing and distance from section or subdivision corner 1520' N. and 634'E.

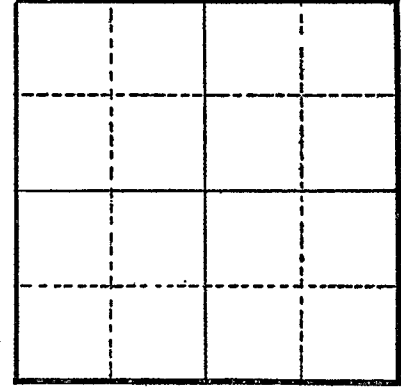

Section _____

Altitude at well _____

TYPE OF WELL: drilled Date Constructed 1946

Depth drilled 101 Depth cased 101

CASING RECORD:
12" from 0 to 101

FINISH:
48 - 1/4 X 3 from 40 to 101

AQUIFERS:

WATER LEVEL:

PUMPING EQUIPMENT: Type Peerless Turbine 6" H.P. 40
Capacity _____ G.P.M.

WELL TESTS:
Drawdown _____ ft. after _____ hours pumping 250 G.P.M.
Drawdown _____ ft. after _____ hours _____ G.P.M.

USE OF WATER Industrial Temp. _____ °F. _____, 19_____

SOURCE OF INFORMATION GR-2976
DRILLER or DIGGER John Beck, Canby, Oregon

ADDITIONAL DATA:
Log _____ Water Level Measurements _____ Chemical Analysis _____ Aquifer Test _____

REMARKS: