

STATE ENGINEER
Salem, Oregon

MA 21. Well Record
13613

STATE WELL NO. 9/LW-10M(2)
COUNTY Marion
APPLICATION NO. GR-3198

OWNER: Stayton Canning Company Coop.


MAILING ADDRESS:

LOCATION OF WELL: Owner's No.

CITY AND STATE: Stayton, Oregon

NW 1/4 SW 1/4 Sec. 10 T. 9 S., R. 1 W., W.M.

Bearing and distance from section or subdivision
corner 1679' N. 683' E.

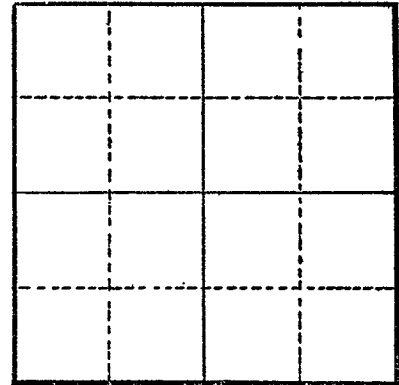

Section

Altitude at well

TYPE OF WELL: drilled Date Constructed 1945

Depth drilled 120 Depth cased 120

CASING RECORD:

12" from 0 to 120 feet

FINISH:

48 - 1/4 X 3 from 40 to 120

AQUIFERS:

WATER LEVEL:

PUMPING EQUIPMENT: Type Peerless Turbine 6" H.P. 25

Capacity 250 G.P.M.

WELL TESTS:

Drawdown no ft. after hours pumping 250 G.P.M.

Drawdown ft. after hours G.P.M.

USE OF WATER Industrial Temp. °F. 19

SOURCE OF INFORMATION GR-2975

DRILLER or DIGGER John Beck, Canby, Oregon

ADDITIONAL DATA:

Log Water Level Measurements Chemical Analysis Aquifer Test

REMARKS: