

STATE ENGINEER  
Salem, Oregon

# Well Record

13617

STATE WELL NO. 9S/1W-10M(3)  
COUNTY Marion  
APPLICATION NO. GR-3200

OWNER: Stayton Canning Company Corp.


MAILING ADDRESS: .....

LOCATION OF WELL: Owner's No. 4

CITY AND STATE: Stayton, Oregon

N E  
NW 1/4 SW 1/4 Sec. 10 T. 9 S., R. 1 W., W.M.

Bearing and distance from section or subdivision corner 1350' N. and 613' E.

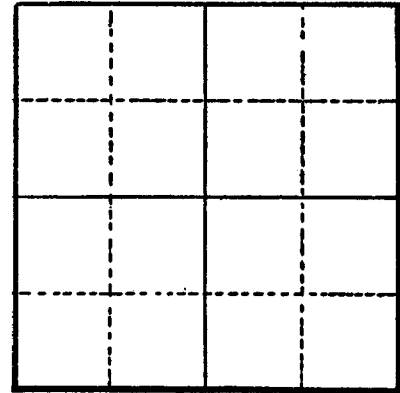

Section .....

Altitude at well .....

TYPE OF WELL: drilled Date Constructed 1953

Depth drilled 485 Depth cased 485

CASING RECORD:

12"

FINISH:

perforations from 40 to 319

AQUIFERS:

top soil, basalt rock, shale, gravel and sand

WATER LEVEL:

PUMPING EQUIPMENT: Type Peerless Turbine H.P. 40  
Capacity ..... G.P.M.

WELL TESTS:

Drawdown ..... ft. after ..... hours pumping 450 ..... G.P.M.

Drawdown ..... ft. after ..... hours ..... G.P.M.

USE OF WATER Industrial Temp. .... °F. ...., 19

SOURCE OF INFORMATION GR-2977

DRILLER or DIGGER John Beck, Canby, Oregon

ADDITIONAL DATA:

Log X Water Level Measurements ..... Chemical Analysis ..... Aquifer Test .....

REMARKS:

top soil 4 1/2 to 4 1/2  
loose river gravel 27 1/2 to 32  
cement gravel 287 to 319  
basalt rock 12 to 331  
brown shale 20 to 351  
blue shale hard & soft 129 to 480  
green quartz sand 5 to 485