

STATE ENGINEER  
Salem, Oregon

MAR. 1952  
12632  
Well Record

STATE WELL NO. 9/1W-11P(1)  
COUNTY Marion  
APPLICATION NO. GR-1168

GR 1129

OWNER: Olive A. Samples


MAILING ADDRESS: Box 101

LOCATION OF WELL: Owner's No.

CITY AND STATE: Stayton, Oregon

SE 1/4 SW 1/4 Sec. 11 T. 9 S. R. 1 W., W.M.

Bearing and distance from section or subdivision corner 1510' E. & 1699' S. of W 1/4 cor. of Sec. 11/

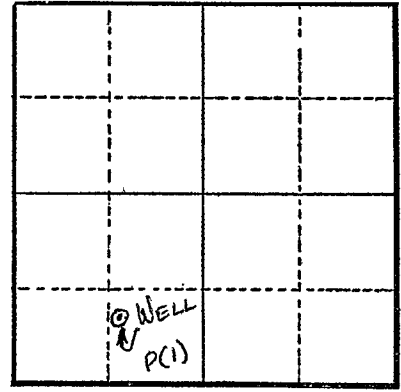

Section 11

Altitude at well 460 ft.

TYPE OF WELL: Drilled Date Constructed 1952

Depth drilled 20 ft. Depth cased 20 ft.

CASING RECORD:

6 inch.

FINISH:

AQUIFERS:

WATER LEVEL:

12 ft.

PUMPING EQUIPMENT: Type Standard Elect. Model 390 Type CN H.P. 1 1/2

Capacity 40 G.P.M.

WELL TESTS:

Drawdown ft. after hours G.P.M.

Drawdown ft. after hours G.P.M.

USE OF WATER Irrigation Temp. °F. 19

SOURCE OF INFORMATION G.R. Record

DRILLER or DIGGER Chas. Hecht

ADDITIONAL DATA:

Log Water Level Measurements Chemical Analysis Aquifer Test

REMARKS:

Log: Soil 0 to 7 ft.  
Rock & coarse gravel 7 to 14 ft.  
Fine sand 14 to 20 ft.

Irrigation of 8.1 acres.