

STATE ENGINEER
Salem, Oregon

MA 11.1111

Well Record

3668

STATE WELL NO. 9/W-15B(1)
COUNTY Marion
APPLICATION NO. GR- 145

OWNER: Town of Stayton


MAILING ADDRESS: City hall

LOCATION OF WELL: Owner's No. 1

CITY AND STATE: Stayton, Oregon

NW 1/4 NE 1/4 Sec. 15 T. 9 S., R. 1 W., W.M.

Bearing and distance from section or subdivision corner 575.25' E. & 146.25' S. of 1/4 cor. on N. line of section 15

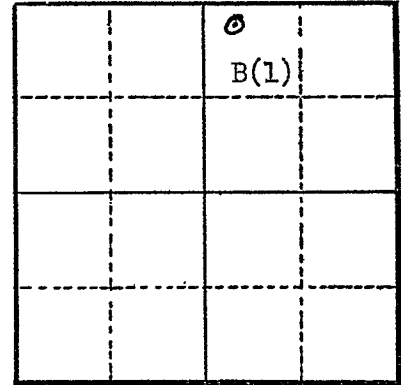

Section 15

Altitude at well

TYPE OF WELL: Dug Date Constructed 1930

Depth drilled 25 Depth cased 25

CASING RECORD:

48 inch concrete casing set from 0 to 25 feet

FINISH:

Slots 7/16 X 3 inch from 15 to 25 feet

AQUIFERS:

WATER LEVEL:

5 feet below land surface (Aug. 1955)

PUMPING EQUIPMENT: Type 5 stage turbine

H.P. 40

Capacity 1000 G.P.M.

WELL TESTS:

Drawdown 18 ft. after 1000 hours G.P.M.

Drawdown ft. after hours G.P.M.

USE OF WATER Municipal Temp. °F. 19

SOURCE OF INFORMATION GR- 139

DRILLER or DIGGER

ADDITIONAL DATA:

Log NA Water Level Measurements Chemical Analysis Aquifer Test

REMARKS:

Infiltration trench: 60' X 18' X 2'