

STATE ENGINEER MARION  
Salem, Oregon

**Well Record**  
13040


STATE WELL NO. 9/W-15J(1)  
COUNTY Marion  
APPLICATION NO. GR-306

OWNER: Dewitt Tiger MAILING ADDRESS: \_\_\_\_\_

LOCATION OF WELL: Owner's No. 1 CITY AND STATE: Stayton, Oregon

NE  $\frac{1}{4}$  SE  $\frac{1}{4}$  Sec. 15 T. 9 S., R. 1 W., W.M.

Bearing and distance from section or subdivision corner S. 56°50'W. 1028' from E.  $\frac{1}{4}$  cor. sec. 15

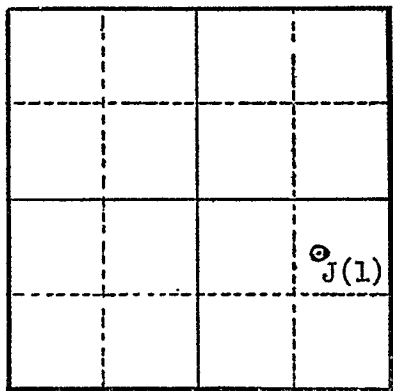

Section 15

Altitude at well 430 (Interpolated)

TYPE OF WELL: Drilled Date Constructed Apr. 1950

Depth drilled 22' Depth cased \_\_\_\_\_

CASING RECORD:  
6 inch

FINISH:

AQUIFERS:

WATER LEVEL:

9 feet below land surface (11/5/56)

PUMPING EQUIPMENT: Type F. M. H.P. 7 $\frac{1}{2}$   
Capacity 100 G.P.M.

WELL TESTS:

Drawdown \_\_\_\_\_ ft. after \_\_\_\_\_ hours \_\_\_\_\_ G.P.M.  
Drawdown \_\_\_\_\_ ft. after \_\_\_\_\_ hours \_\_\_\_\_ G.P.M.

USE OF WATER Irrigation (27 $\frac{1}{2}$  acres) Temp. \_\_\_\_\_ °F. \_\_\_\_\_, 19\_\_\_\_

SOURCE OF INFORMATION GR-285

DRILLER or DIGGER \_\_\_\_\_

ADDITIONAL DATA:

Log NA Water Level Measurements \_\_\_\_\_ Chemical Analysis \_\_\_\_\_ Aquifer Test \_\_\_\_\_

REMARKS: