

STATE ENGINEER
Salem, Oregon

MARI.....
13748

Well Record

STATE WELL NO. 9/1W-18D(1)
COUNTY Marion
APPLICATION NO. GR- 700

OWNER: Ben O. Cole


MAILING ADDRESS: Rt. 1 Box 161

LOCATION OF WELL: Owner's No. 1

CITY AND STATE: Aumsville, Oregon

NW 1/4 NW 1/4 Sec. 18 T. 9 S., R. 1 W., W.M.

Bearing and distance from section or subdivision corner 1150' E. & 600' S. of NW cor. sec. 18

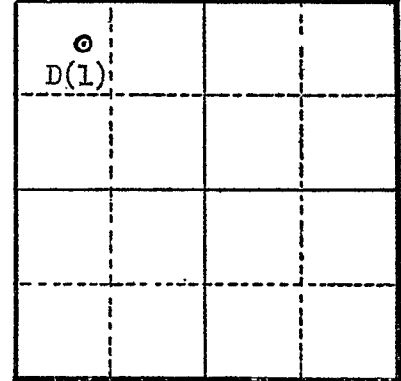

Section 18

Altitude at well 390' (Interpolated)

TYPE OF WELL: Dug Date Constructed May 1955

Depth drilled 5' Depth cased

CASING RECORD:

Sump: 40' X 10' X 5' (open)

FINISH:

AQUIFERS:

WATER LEVEL:
3 feet

PUMPING EQUIPMENT: Type Centrifugal H.P. 3
Capacity G.P.M.

WELL TESTS:

Drawdown ft. after hours G.P.M.
Drawdown ft. after hours G.P.M.

USE OF WATER Irrigation (4 acres) Temp. °F., 19

SOURCE OF INFORMATION GR- 649

DRILLER or DIGGER

ADDITIONAL DATA:

Log NA Water Level Measurements Chemical Analysis Aquifer Test

REMARKS: