

STATE ENGINEER
Salem, Oregon

13751
MARION.....

Well Record

GR- 1150

STATE WELL NO. 9/1W-18K
COUNTY Marion
APPLICATION NO. GR- 1189

OWNER: Michael Mack

MAILING
ADDRESS:

LOCATION OF WELL: Owner's No.


CITY AND
STATE:

Aumsville, Oregon

NW 1/4 SE 1/4 Sec. 18 T. 9 S., R. 1 W., W.M.

Bearing and distance from section or subdivision

corner 2079' N. & 264' E. from S 1/4 cor. Sec. 18.

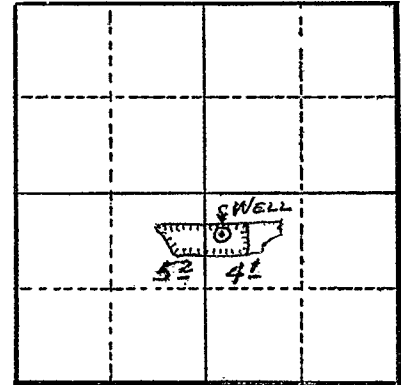

Section 18

Altitude at well

TYPE OF WELL: Drilled Date Constructed 1954

Depth drilled 40 ft. Depth cased 40 ft.

CASING RECORD:

8 inch

FINISH:

AQUIFERS:

WATER LEVEL:

9 ft.

PUMPING EQUIPMENT: Type 1 1/4 in. Cent. H.P. 10

Capacity 104 G.P.M.

WELL TESTS:

Drawdown 10 ft. after 300 hours G.P.M.

Drawdown ft. after hours G.P.M.

USE OF WATER Irrigation Temp. °F. 19

SOURCE OF INFORMATION G. R. Record

DRILLER or DIGGER

ADDITIONAL DATA:

Log N.A. Water Level Measurements Chemical Analysis Aquifer Test

REMARKS:

Irrigation of 9.3 acres.