

STATE ENGINEER
Salem, Oregon

M121.....

Well Record

13760

STATE WELL NO. 9/W-18Q(1)
COUNTY Marion
APPLICATION NO. GR-479

OWNER: Fred W. & Minnie Dickman

MAILING ADDRESS: Rt. 1 Box 92


LOCATION OF WELL: Owner's No. 1

CITY AND STATE: Aumsville, Oregon

SW 1/4 SE 1/4 Sec. 18 T. 9 S, R. 1 W., W.M.

Bearing and distance from section or subdivision

corner 67.4' N. & 1603' W. from SE cor. of sec. 18

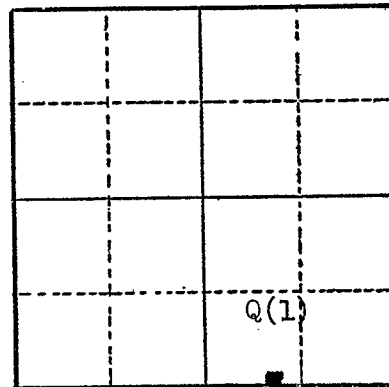

Section 18

Altitude at well 380' (Interpolated)

TYPE OF WELL: Dug Date Constructed May 1947

Depth drilled 17' Depth cased open hole

CASING RECORD:

Sump: 10' X 20'

FINISH:

AQUIFERS:

Sand & gravel

WATER LEVEL:

6 feet below land surface

PUMPING EQUIPMENT: Type Centrifugal

H.P. 30

Capacity 800 G.P.M.

WELL TESTS:

Drawdown 1 ft. after 700 hours G.P.M.

Drawdown ft. after hours G.P.M.

USE OF WATER Irrigation (147 acres) Temp. °F., 19

SOURCE OF INFORMATION GR-461

DRILLER or DIGGER

ADDITIONAL DATA:

Log NA Water Level Measurements Chemical Analysis Aquifer Test

REMARKS: