

STATE ENGINEER  
Salem, Oregon

MARION  
13784

# Well Record

STATE WELL NO. 9/W-19B(1)  
COUNTY Marion  
APPLICATION NO. GR-479

OWNER: Fred W. & Minnie Dickman


MAILING ADDRESS: Rt. 1 Box 92

LOCATION OF WELL: Owner's No. 2

CITY AND STATE: Aumsville, Oregon

NW 1/4 NE 1/4 Sec. 19 T. 9 S. R. 1 W., W.M.

Bearing and distance from section or subdivision corner 1010' S. & 2189' W. from NE cor. sec. 19

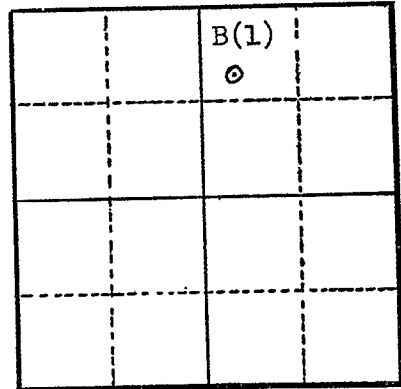

Section 19

Altitude at well 380' (Interpolated)

TYPE OF WELL: Drilled Date Constructed May 1948

Depth drilled 25' Depth cased 25'

CASING RECORD:  
8 inch from 0 to 25 feet

### FINISH:

Perforated from 7 to 25 feet

### AQUIFERS:

WATER LEVEL:  
9 feet below land surface

PUMPING EQUIPMENT: Type Centrifugal H.P. 15  
Capacity 600 G.P.M.

WELL TESTS:  
Drawdown 6 ft. after 100 hours G.P.M.  
Drawdown ft. after hours G.P.M.

USE OF WATER Irrigation (147 acres) Temp. °F. 19

SOURCE OF INFORMATION GR-461

DRILLER or DIGGER

ADDITIONAL DATA:  
Log NA Water Level Measurements Chemical Analysis Aquifer Test

### REMARKS: