

STATE ENGINEER  
Salem, Oregon

MARION  
13785


# Well Record

STATE WELL NO. 9/W - 19E  
COUNTY MARION  
APPLICATION NO. GR-1992

OWNER: T. R. & Carrie L. Hammer  
MAILING ADDRESS: Rt. 1, Box 100

LOCATION OF WELL: Owner's No.  
CITY AND STATE: Aumsville, Oregon

SW 1/4 NW 1/4 Sec. 19 T. 9 N. S., R. 1 E. W.M.  
Bearing and distance from section or subdivision  
corner 462' E. and 528' N.

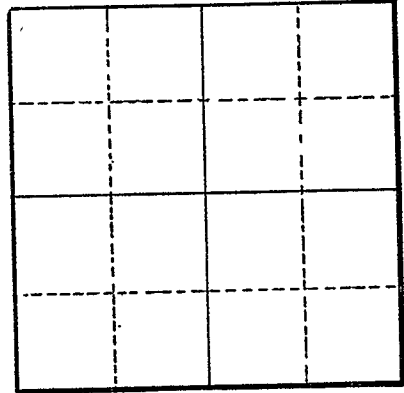

Section

Altitude at well

TYPE OF WELL: Drilled Date Constructed 1954

Depth drilled 20.0 Depth cased 20

### CASING RECORD:

8-inch

### FINISH:

Perforations from 11 to 20

### AQUIFERS:

Soil and fine gravel

### WATER LEVEL:

6-8-feet

PUMPING EQUIPMENT: Type Used Centrifugal H.P.  
Capacity 180 plus G.P.M.

WELL TESTS:  
Drawdown 0 ft. after hours Pumping 180 G.P.M.  
Drawdown ft. after hours G.P.M.

USE OF WATER Irrigation Temp. °F., 19

SOURCE OF INFORMATION GR-1922  
DRILLER or DIGGER West, Salem, Oregon

ADDITIONAL DATA:  
Log  Water Level Measurements Chemical Analysis Aquifer Test

### REMARKS:

Soil  
Gravel, fine

6 to 6  
14 to 20