

STATE ENGINEER
Salem, Oregon

M 121.86
13786

Well Record

STATE WELL NO. 9/LW-19F(1)
COUNTY Marion
APPLICATION NO. GR-467

OWNER: John & Tina Freeman


MAILING ADDRESS: Box 61

LOCATION OF WELL: Owner's No. 1

CITY AND STATE: Stayton, Oregon

SE 1/4 NW 1/4 Sec. 19 T. 9 S, R. 1 W., W.M.

Bearing and distance from section or subdivision corner N.49°15'W. 6.21 Ch. from SE cor. of the George Neal DIC

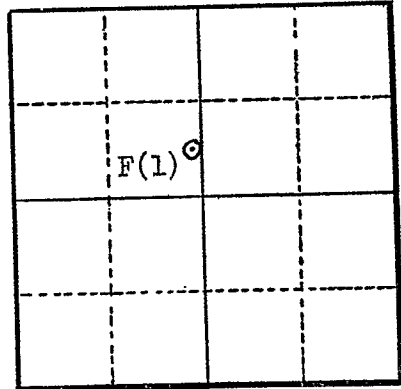

Section 19

Altitude at well 370' (Interpolated)

TYPE OF WELL: Drilled Date Constructed 1948

Depth drilled 27' Depth cased 27'

CASING RECORD:

10 inch from 0 to 27 feet

FINISH:

AQUIFERS:

Sand & gravel from 17 to 27 feet

WATER LEVEL:

24 feet below land surface

PUMPING EQUIPMENT: Type 2" Centrifugal

H.P. 5

Capacity 127+ G.P.M.

WELL TESTS:

Drawdown ft. after hours G.P.M.

Drawdown ft. after hours G.P.M.

USE OF WATER Irrigation (5.8 acres) Temp. °F., 19

SOURCE OF INFORMATION GR-449

DRILLER or DIGGER

ADDITIONAL DATA:

Log Water Level Measurements Chemical Analysis Aquifer Test

REMARKS:

Sandy loam
Gravel

0 to 17
17 to 27