

STATE ENGINEER
Salem, Oregon

Well Record

STATE WELL NO. 9/W-19F(2)
COUNTY Marion
APPLICATION NO. GR-482

MAR 13 1947

OWNER: Schieman Bros.


MAILING ADDRESS: Rt. 1 Box 97

LOCATION OF WELL: Owner's No. 1

CITY AND STATE: Aumsville, Oregon

SE 1/4 NW 1/4 Sec. 19 T. 9 ^{XN.} S., R. 1 ^{XK} W., W.M.

Bearing and distance from section or subdivision corner N.67°15'W. 19.01 ch. from SE cor. of the George Neal DLC

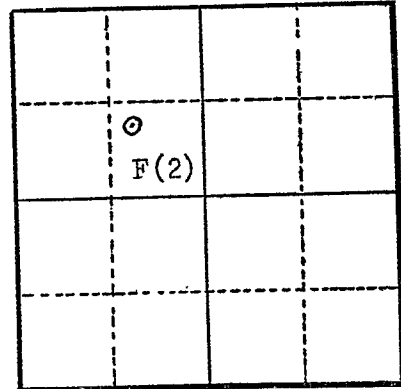

Section 19

Altitude at well 360' (Interpolated)

TYPE OF WELL: Drilled Date Constructed May 1946

Depth drilled 25' Depth cased 25'

CASING RECORD:
8 inch from 0 to 25 feet

FINISH: 3/4 X 6 inch slots from 19 to 25 feet

AQUIFERS:
Gravel (river) from 8 to 25 feet

WATER LEVEL:
10 feet below LSD

PUMPING EQUIPMENT: Type 3 X 4 inch centrifugal H.P. 15
Capacity G.P.M.

WELL TESTS:
Drawdown 2 ft. after hours 260+ G.P.M.
Drawdown ft. after hours G.P.M.

USE OF WATER Irrigation (35.22 acres) Temp. °F., 19.....
SOURCE OF INFORMATION GR-464

DRILLER or DIGGER
ADDITIONAL DATA:
Log X Water Level Measurements Chemical Analysis Aquifer Test

REMARKS:
Sand 0 to 8
Gravel 8 to 25