

STATE ENGINEER
Salem, Oregon

MARION
13748

Well Record

STATE WELL NO. 9/1W - 19G
COUNTY MARION
APPLICATION NO. GR-2185

OWNER: Evelyn E. Hatch


MAILING ADDRESS: Rt. 1, Box 95

LOCATION OF WELL: Owner's No. #2

CITY AND STATE: Aumsville, Oregon

SW 1/4 NE 1/4 Sec. 19 T. 9 S., R. 1 W., W.M.

Bearing and distance from section or subdivision corner 2013' W. and 495' N.

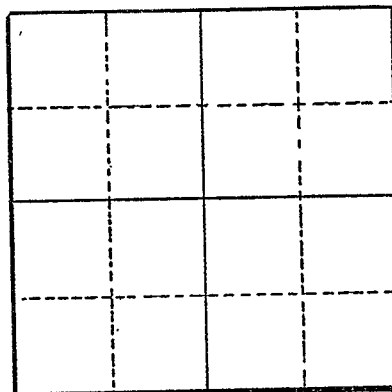

Section

Altitude at well

TYPE OF WELL: Drilled Date Constructed 1948

Depth drilled 25 Depth cased 25

CASING RECORD:

8-Inch

FINISH:

Perforations from 13 to 25

AQUIFERS:

WATER LEVEL:

15-Feet

PUMPING EQUIPMENT: Type Cornell Centrifugal H.P. 10
Capacity 200 G.P.M.

WELL TESTS:

Drawdown 5 ft. after hours Pumping 200 G.P.M.
Drawdown ft. after hours G.P.M.

USE OF WATER Irrigation Temp. °F., 19

SOURCE OF INFORMATION GR-2090

DRILLER or DIGGER

ADDITIONAL DATA:

Log Water Level Measurements Chemical Analysis Aquifer Test

REMARKS: