

STATE ENGINEER
Salem, Oregon

MAR. 13 1955
Well Record

STATE WELL NO. 9/W - 19H
COUNTY MARION
APPLICATION NO. GR-2186

OWNER: Evelyn E. Hatch


MAILING ADDRESS: Rt. 1, Box 95

LOCATION OF WELL: Owner's No. #1

CITY AND STATE: Aumsville, Oregon

SE 1/4 NE 1/4 Sec. 19 T. 9 N. S. R. 1 E. W., W.M.

Bearing and distance from section or subdivision corner 1254' W. and 528' N.

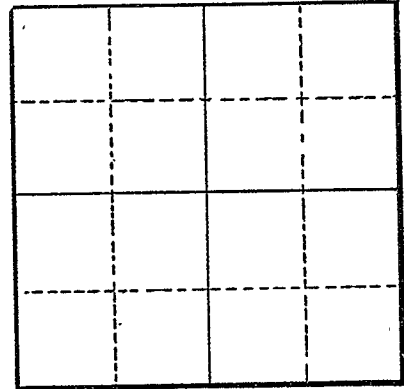

Section

Altitude at well

TYPE OF WELL: Dug Date Constructed 1955

Depth drilled 12 Depth cased 12

CASING RECORD:

8-Inch
16-Inch

FINISH:

AQUIFERS:

Gravel

WATER LEVEL:

2-Feet

PUMPING EQUIPMENT: Type Cornell Centrifugal H.P. 10
Capacity 200 G.P.M.

WELL TESTS:

Drawdown 1 1/2 ft. after hours Pumping 200 G.P.M.
Drawdown ft. after hours G.P.M.

USE OF WATER Irrigation Temp. °F., 19

SOURCE OF INFORMATION GR-2091

DRILLER or DIGGER

ADDITIONAL DATA:

Log X Water Level Measurements Chemical Analysis Aquifer Test

REMARKS:

Gravel 0 12