

STATE ENGINEER
Salem, Oregon

MARION
13791

Well Record

STATE WELL NO. 9/1W - 19M
COUNTY MARION
APPLICATION NO. GR-1993

OWNER: E. A. & V. E. Hammer


MAILING ADDRESS: Rt. 1, Box 191

LOCATION OF WELL: Owner's No. _____

CITY AND STATE: Aumsville, Oregon

NW 1/4 SW 1/4 Sec. 19 T. 9 S., R. 1 W., W.M.

Bearing and distance from section or subdivision corner 990' E. and 429' S.

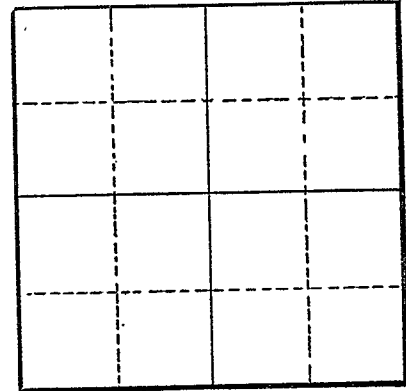

Section _____

Altitude at well _____

TYPE OF WELL: Drilled Date Constructed 1951

Depth drilled 19 Depth cased 19

CASING RECORD:

8-inch

FINISH:

Perforations from 9 to 19

AQUIFERS:

Sand

WATER LEVEL:

8-feet

PUMPING EQUIPMENT: Type Cornell Centrifugal H.P. 15
Capacity 424 G.P.M.

WELL TESTS:

Drawdown 3 ft. after _____ hours Pumping 550 G.P.M.
Drawdown 12 ft. after _____ hours Pumping 450 G.P.M.

USE OF WATER Irrigation Temp. _____ °F. _____, 19

SOURCE OF INFORMATION GR-1923

DRILLER or DIGGER West, Salem, Oregon

ADDITIONAL DATA:

Log Water Level Measurements _____ Chemical Analysis _____ Aquifer Test _____

REMARKS:

Sand some dirt	6 to 6
Sand & small gravel	6 to 12
Blue clay	1 1/2 to 13 1/2
Gravel & some sand	13 1/2 to 19