

STATE ENGINEER
Salem, Oregon

Well Record

STATE WELL NO. 9/1W-19M(1)
COUNTY Marion
APPLICATION NO. GR- 326

OWNER: Anna E. Stanley

MAILING
ADDRESS: Rt. 1 Box 103


LOCATION OF WELL: Owner's No. 1

CITY AND
STATE: Aumsville, Oregon

NW $\frac{1}{4}$ SW $\frac{1}{4}$ Sec. 19 T. 9 S., R. 1 W., W.M.

Bearing and distance from section or subdivision

corner 750' S. & 500' E. from W $\frac{1}{4}$ cor. sec. 19

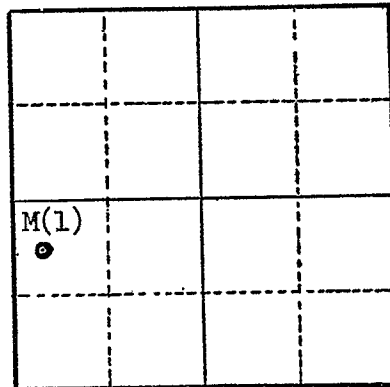

Section 19

Altitude at well 370' (Interpolated)

TYPE OF WELL: Drilled Date Constructed Spring 1944

Depth drilled 22 $\frac{1}{2}$ ' Depth cased 22 $\frac{1}{2}$ '

CASING RECORD:

8 inch from 0 to 22 $\frac{1}{2}$ feet

FINISH:

Perforated from 12 to 22 $\frac{1}{2}$ feet

AQUIFERS:

WATER LEVEL:

6 to 10 feet - Spring & Fall seasons

PUMPING EQUIPMENT: Type G. E. rain-flow H.P. 15
Capacity 175 G.P.M.

WELL TESTS:

Drawdown ft. after hours G.P.M.
Drawdown ft. after hours G.P.M.

USE OF WATER Irrigation (40 acres) Temp. °F., 19....

SOURCE OF INFORMATION GR- 308

DRILLER or DIGGER

ADDITIONAL DATA:

Log NA Water Level Measurements Chemical Analysis Aquifer Test

REMARKS: