

STATE ENGINEER  
Salem, Oregon

13793  
M121

# Well Record

STATE WELL NO. 9/1W-19N(1)  
COUNTY Marion  
APPLICATION NO. GR- 471

OWNER: Alfred, Carl & Lucille Hofmann


MAILING ADDRESS: Rt. 1 Box 109

LOCATION OF WELL: Owner's No. 1

CITY AND STATE: Aumsville, Oregon

SW 1/4 SW 1/4 Sec. 19 T. 9 S., R. 1 W., W.M.

Bearing and distance from section or subdivision corner N.30°06'E. 10.986 ch. from SW cor. sec. 19

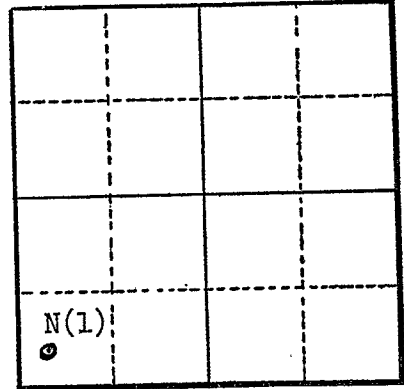

Section 19

Altitude at well 365' (Interpolated)

TYPE OF WELL: Drilled Date Constructed May 1941

Depth drilled 24' Depth cased 24'

CASING RECORD:  
8 inch from 0 to 24 feet

FINISH: 3/4 X 6 inch slots from 14 to 24 feet

AQUIFERS:  
Gravel from 8 to 24 feet

WATER LEVEL:  
12 feet below LSD

PUMPING EQUIPMENT: Type F.M. Centrifugal 3" X 2" H.P. 10  
Capacity 200 G.P.M.

WELL TESTS:  
Drawdown 8 ft. after ..... hours 200 G.P.M.  
Drawdown ..... ft. after ..... hours ..... G.P.M.

USE OF WATER Irrigation (20 acres) Temp. °F. ...., 19

SOURCE OF INFORMATION GR- 453

DRILLER or DIGGER

ADDITIONAL DATA:  
Log  Water Level Measurements ..... Chemical Analysis ..... Aquifer Test .....

REMARKS:  
Sandy loam 0 to 8  
Gravel 8 to 24