

STATE ENGINEER
Salem, Oregon

MA 21
13797

Well Record

STATE WELL NO. 9/1W-19P(1)
COUNTY Marion
APPLICATION NO. GR-501

OWNER: Delbert & Agnes Sanders


MAILING ADDRESS: Rt. 2, Box 230

LOCATION OF WELL: Owner's No. 1

CITY AND STATE: Scio, Oregon

SE ¼ SW ¼ Sec. 19 T. 9 S., R. 1 W., W.M.

Bearing and distance from section or subdivision corner N. 79° 48' E. 22.2 chs. from SW cor. Sec. 19

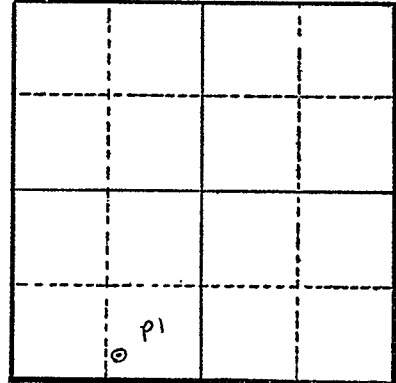

Altitude at well 370 ft.

TYPE OF WELL: drilled Date Constructed 1930 or prior

Depth drilled 24 Depth cased 24

Section 19

CASING RECORD: 8 inch

FINISH:

AQUIFERS:

WATER LEVEL: 12 to 18 ft.

PUMPING EQUIPMENT: Type Cornell centrifugal H.P. 15
Capacity 400 G.P.M.

WELL TESTS:
Drawdown 20 ft. after _____ hours 400 G.P.M.
Drawdown _____ ft. after _____ hours _____ G.P.M.

USE OF WATER irrigation 41.3 acres Temp. _____ °F. _____, 19

SOURCE OF INFORMATION GR-501

DRILLER or DIGGER _____

ADDITIONAL DATA:

Log X Water Level Measurements _____ Chemical Analysis _____ Aquifer Test _____

REMARKS: Log: Sandy soil 0 to 5 ft.
River gravel 5 to 24 ft.