

STATE ENGINEER  
Salem, Oregon

MAR 1950  
13798

# Well Record

STATE WELL NO. 9/LW-19P(2)  
COUNTY Marion  
APPLICATION NO. GR-501

OWNER: Delbert & Agnes Sanders

MAILING ADDRESS: Rt. 2, Box 230


LOCATION OF WELL: Owner's No.

CITY AND STATE: Scio, Oregon

SE 1/4 SW 1/4 Sec. 19 T. 9 S., R. 1 W., W.M.

Bearing and distance from section or subdivision

corner N. 71° 30' E. 33.3 chs. from SW cor. Sec. 19

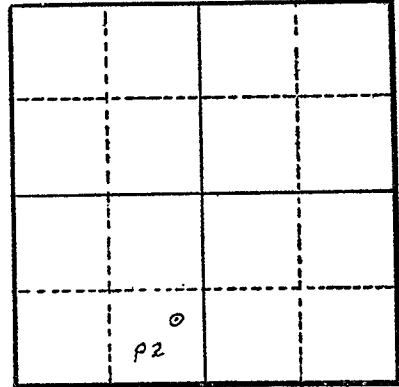

Section 19

Altitude at well 370 ft.

TYPE OF WELL: drilled Date Constructed 1950

Depth drilled 21 Depth cased 20

CASING RECORD: 10 inch

FINISH:

AQUIFERS:

WATER LEVEL: 5 ft. to 9 ft.

PUMPING EQUIPMENT: Type centrifugal H.P. 25  
Capacity 700 G.P.M.

WELL TESTS:  
Drawdown 9 ft. after 700 hours G.P.M.  
Drawdown ft. after hours G.P.M.

USE OF WATER irrigation 41.3 acres Temp. °F., 19.

SOURCE OF INFORMATION GR-501  
DRILLER or DIGGER Henry Robinson

ADDITIONAL DATA:  
Log  Water Level Measurements  Chemical Analysis  Aquifer Test

REMARKS: Log: Sandy soil 0 to 4 ft.  
River gravel 4 to 21 ft.