

STATE ENGINEER
Salem, Oregon

MARI...381

Well Record


STATE WELL NO. 4/2W-34C(1)
COUNTY Marion
APPLICATION NO. GR-337

OWNER: Patrick J. & Dolores Johnston Mailing ADDRESS: Route 1, Box 317

LOCATION OF WELL: Owner's No. #1 CITY AND STATE: Woodburn, Oregon

NE 1/4 NW 1/4 Sec. 34 T. 4 N. S., R. 2 E. W.M.

Bearing and distance from section or subdivision
corner 2000' E. & 880' S. from NW cor. of SEC.
34, T. 4 S., R. 2 W.

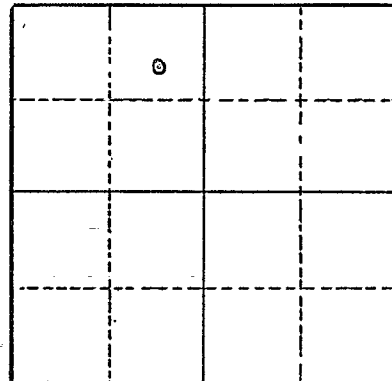

Altitude at well 165' Interpolated

TYPE OF WELL: Drilled Date Constructed 3/4/55

Depth drilled 104 Depth cased 104

Section 34

CASING RECORD:

14 inch casing set from 0 to 72 feet
10 inch casing set from 0 to 104 feet

FINISH:

unknown

AQUIFERS:

unknown

WATER LEVEL:

21 feet below land surface April 12

PUMPING EQUIPMENT: Type Jacuzzi turbine H.P. 25
Capacity 350 G.P.M.

WELL TESTS:

Drawdown 52 ft. after pumping 400 hours G.P.M.
Drawdown ft. after hours G.P.M.

USE OF WATER Irrigation 78 acres Temp. °F. 19

SOURCE OF INFORMATION Reg. Statement GR-337

DRILLER or DIGGER J. T. Miller Aurora, Oregon

ADDITIONAL DATA:

Log No Water Level Measurements Chemical Analysis Aquifer Test

REMARKS: