

STATE ENGINEER
Salem, Oregon

MARION
13813

Well Record


STATE WELL NO. 9/1W-20H
COUNTY MARION
APPLICATION NO. GR-2487

OWNER: Dorsey B. Gray
MAILING ADDRESS: Rt. 1, Box 87

LOCATION OF WELL: Owner's No. #2
CITY AND STATE: Aunsville, Oregon

SE 1/4 NE 1/4 Sec. 20 T. 9 S., R. 1 W., W.M.

Bearing and distance from section or subdivision
corner 1288.7' W. 1350.9' S.

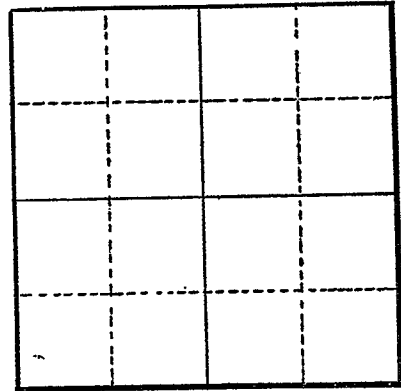

Section

Altitude at well

TYPE OF WELL: Drilled Date Constructed 1955

Depth drilled 47 Depth cased

CASING RECORD:

10-inch

FINISH:

AQUIFERS:

Clay, loam, sand and gravel

WATER LEVEL:

9-feet

PUMPING EQUIPMENT: Type Fairbanks Morse H.P. 15
Capacity 400 G.P.M.

WELL TESTS:

Drawdown ft. after hours G.P.M.
Drawdown ft. after hours G.P.M.

USE OF WATER Irrigation Temp. °F., 19

SOURCE OF INFORMATION GR-2355

DRILLER or DIGGER

ADDITIONAL DATA:

Log Water Level Measurements Chemical Analysis Aquifer Test

REMARKS:

Clay & loam 17'
Sand & Gravel 17 - 21'
Cemented gravel 21 - 28'
Sand & Gravel 28 - 31'
Cemented Gravel 31 - 43'

Sand & Gravel 43 - 47'