

STATE ENGINEER  
Salem, Oregon

MARION  
1388A

# Well Record

STATE WELL NO. 9/1W-20G  
COUNTY MARION  
APPLICATION NO. GR-2486

OWNER: Dorsey B. Gray


MAILING ADDRESS: Rt. 1, Box 87

LOCATION OF WELL: Owner's No. #1

CITY AND STATE: Aumsville, Oregon

SW 1/4 NE 1/4 Sec. 20 T. 9 S. R. 1 W., W.M.

Bearing and distance from section or subdivision corner West 2511.7' S. 2389.7'

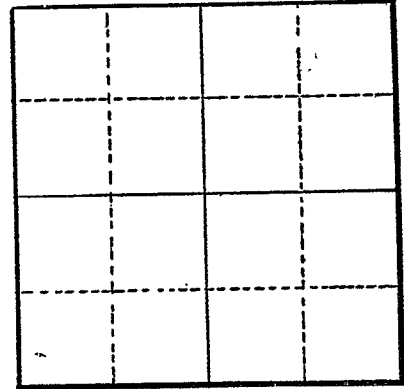

Section

Altitude at well

TYPE OF WELL: Drilled Date Constructed 1947

Depth drilled 31 1/2 Depth cased

### CASING RECORD:

10-inch

### FINISH:

### AQUIFERS:

### WATER LEVEL:

8-feet

PUMPING EQUIPMENT: Type Jacuzzi H.P. 15  
Capacity 400 G.P.M.

### WELL TESTS:

Drawdown ft. after hours G.P.M.  
Drawdown ft. after hours G.P.M.

USE OF WATER Irrigation Temp. °F., 19

SOURCE OF INFORMATION GR-2354  
DRILLER or DIGGER Wyore, Address Unknown

### ADDITIONAL DATA:

Log Water Level Measurements Chemical Analysis Aquifer Test

### REMARKS: