

STATE ENGINEER
Salem, Oregon

MAR. 1384

Well Record

STATE WELL NO. 4/2W-347(1)
COUNTY Marion
APPLICATION NO.

OWNER: V. G. Earnst


MAILING ADDRESS:

LOCATION OF WELL: Owner's No.

CITY AND STATE:

1/4 1/4 Sec. T. N. E. S, R. W., W.M.

Bearing and distance from section or subdivision corner

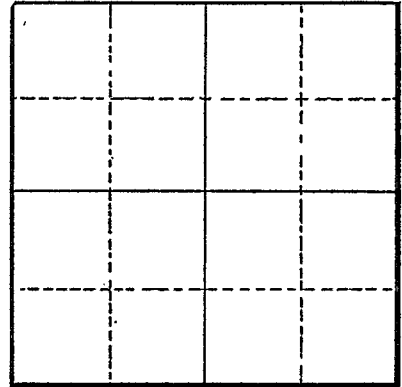

Section

Altitude at well 172

TYPE OF WELL: Drilled Date Constructed 1952

Depth drilled 80 Depth cased 78

CASING RECORD:

8 inch

FINISH:

Open bottom, casing unperforated

AQUIFERS:

Black sand from 79 to 80

WATER LEVEL:

PUMPING EQUIPMENT: Type Turbine H.P. 7 1/2
Capacity G.P.M.

WELL TESTS:

Drawdown ft. after hours G.P.M.
Drawdown ft. after hours G.P.M.

USE OF WATER Domestic, Irr. 27 acres Temp. °F., 19

SOURCE OF INFORMATION USGS

DRILLER or DIGGER

ADDITIONAL DATA:

Log Water Level Measurements Chemical Analysis Aquifer Test

REMARKS:

