

STATE ENGINEER
Salem, Oregon

MAR 1 1385

Well Record

STATE WELL NO. 4/2W - 34K
COUNTY MARION
APPLICATION NO. GR-1907

OWNER: William H. Baillie


MAILING ADDRESS: 1005 N. Church Street

LOCATION OF WELL: Owner's No. _____

CITY AND STATE: Salem, Oregon

NW $\frac{1}{4}$ SE $\frac{1}{4}$ Sec. 34 T. 4 N. S., R. 2 E. W., W.M.

Bearing and distance from section or subdivision corner 1490' W. & 1620' N.

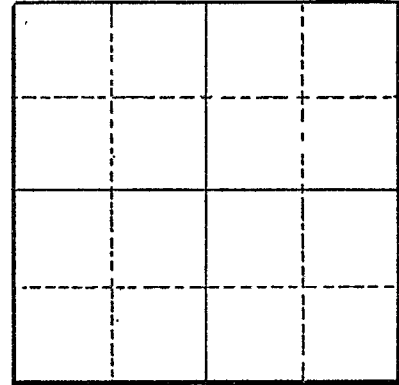

Section _____

Altitude at well 165

TYPE OF WELL: Drilled Date Constructed 1944

Depth drilled 76' Depth cased 76'

CASING RECORD:

12-inch

FINISH:

AQUIFERS:

Clay and sand

WATER LEVEL:

6-feet

PUMPING EQUIPMENT: Type Lane-Bowler Turbine 4-inch column H.P. 10
Capacity 110 G.P.M.

WELL TESTS:

Drawdown ? ft. after _____ hours Pumping 250 G.P.M.

Drawdown _____ ft. after _____ hours _____ G.P.M.

USE OF WATER Irrigation - 54 acres Temp. _____ °F. _____, 19____

SOURCE OF INFORMATION GR-1907

DRILLER or DIGGER Unknown

ADDITIONAL DATA:

Log Water Level Measurements _____ Chemical Analysis _____ Aquifer Test _____

REMARKS:

Clay and sand