

STATE ENGINEER
Salem, Oregon

MAR 11 1951 1386

Well Record

STATE WELL NO. 4/2W-34P(1)
COUNTY Marion
APPLICATION NO. GR-73

OWNER: Charles R. Johnston


MAILING ADDRESS: Route 1, Box 314

LOCATION OF WELL: Owner's No. #1

CITY AND STATE: Woodburn, Oregon

SE 1/4 SW 1/4 Sec. 34 T. 4 N. 4 S., R. 2 E. W.M.

Bearing and distance from section or subdivision corner 400' N. & 200' W. from S 1/4 cor. Sec. 34

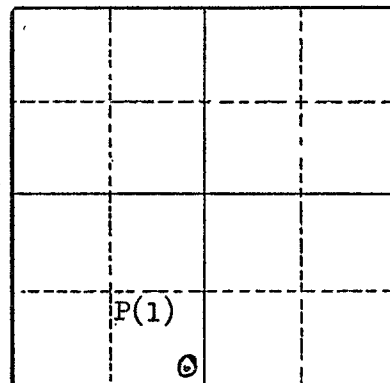

Section 34

Altitude at well 175' Interpolated

TYPE OF WELL: Drilled Date Constructed 7/10/51

Depth drilled 105' Depth cased 105'

CASING RECORD:

10 inch casing #31.20 set from 0 to 105 feet

FINISH:

Perforated but no record

AQUIFERS:

WATER LEVEL:

20 feet below land surface 7/21/51

PUMPING EQUIPMENT: Type Jacuzzi turbine 8 stage H.P. 30
Capacity 500 G.P.M.

WELL TESTS:

Drawdown 40 ft. after 600 hours G.P.M.

Drawdown ft. after hours G.P.M.

USE OF WATER Irrigation 30 acres Temp. °F. 19

SOURCE OF INFORMATION GR-73

DRILLER or DIGGER Perkins Drilling Co.

ADDITIONAL DATA:

Log No. Water Level Measurements Chemical Analysis Aquifer Test

REMARKS: