

STATE ENGINEER
Salem, Oregon

M. A. R. I. ...
1876
Marion
Well Record


STATE WELL NO. 9/2W-1P
COUNTY Marion
APPLICATION NO. GR-3985

OWNER: Walter D. Miller
Fernando M. Smith
LOCATION OF WELL: Owner's No.

MAILING ADDRESS:
CITY AND STATE: Stayton, Oregon

SE 1/4 SW 1/4 Sec. 1 T. 9 S., R. 2 W., W.M.

Bearing and distance from section or subdivision
corner 1000' S. to 1/4 Sec. Cor. of Sec. 1 & 12

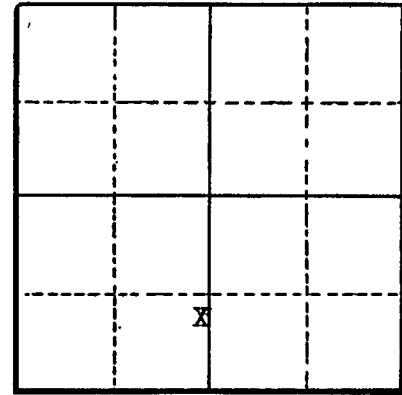

Altitude at well

TYPE OF WELL: Drilled Date Constructed June, 1944

Depth drilled 38 ft. Depth cased 38 ft.

Section 1

CASING RECORD:

8 inch casing set to 38 feet

FINISH:

1/2 inch perforations from 18 to 38 feet

AQUIFERS:

WATER LEVEL:

2 feet below surface

PUMPING EQUIPMENT: Type H.P.
Capacity G.P.M.

WELL TESTS:
Drawdown 15 ft. after hours 150 G.P.M.
Drawdown ft. after hours G.P.M.

USE OF WATER Irrigation Temp. °F., 19
SOURCE OF INFORMATION Well Registration Statement Cert. # GR-3597
DRILLER or DIGGER Mr. West

ADDITIONAL DATA:

Log Water Level Measurements Chemical Analysis Aquifer Test

REMARKS: